


T.2S.R.1W.W.M.

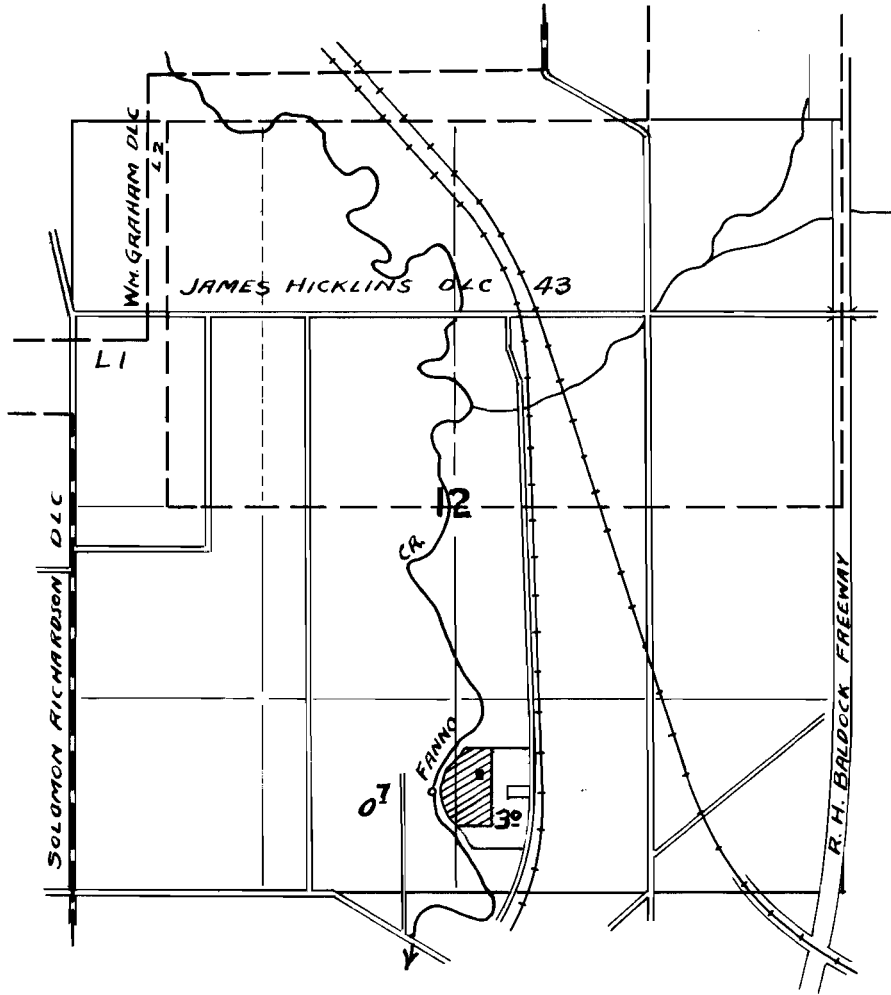

FINAL PROOF SURVEY

UNDER

Application No. 25658 Permit No. 20235

IN NAME OF

ELMER SCHREINER

Surveyed 5 - 8 1956, by R.H. WHITBY