


T.13S.R.34E.W.M.

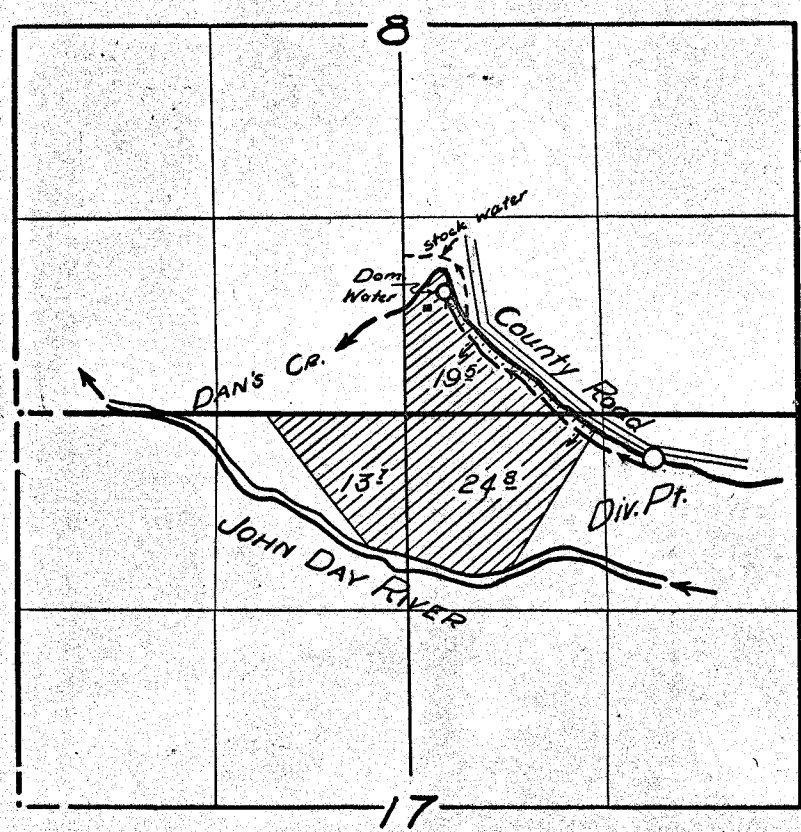

FINAL PROOF SURVEY
 UNDER

Application No. 25938 Permit No. 20464
 IN NAME OF

GARLAND MEADOR

Surveyed 20 Oct. 1955 by [Signature]