


T. 13 S. R. 34 E. W.M.

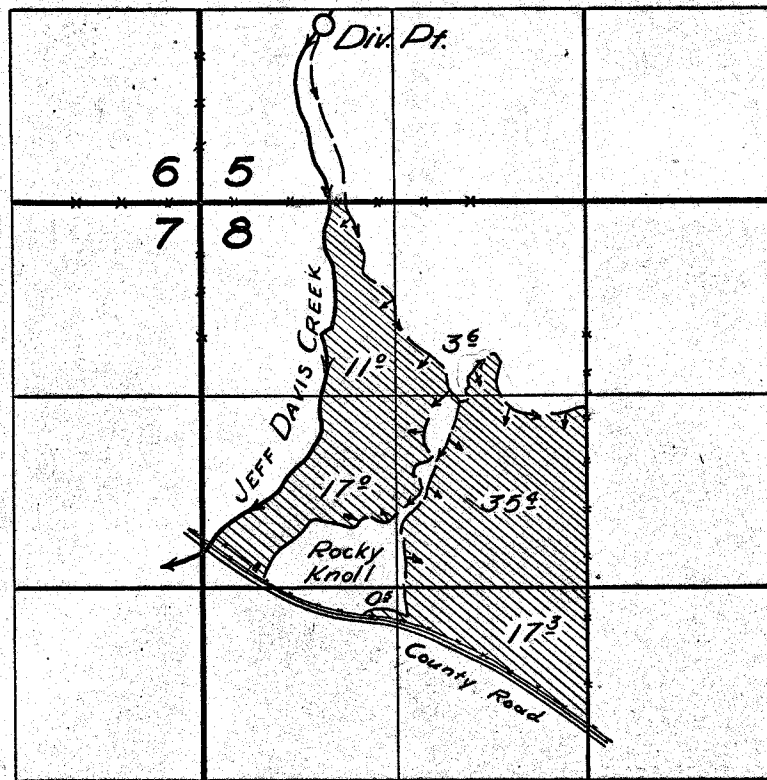

FINAL PROOF SURVEY
UNDER

Application No. 25939 Permit No. 20341
IN NAME OF

GEORGE T. MEADOR

Surveyed 20 Oct. 1955, by *D. S. [Signature]*