


T. 6N. R. 5W. W. M.

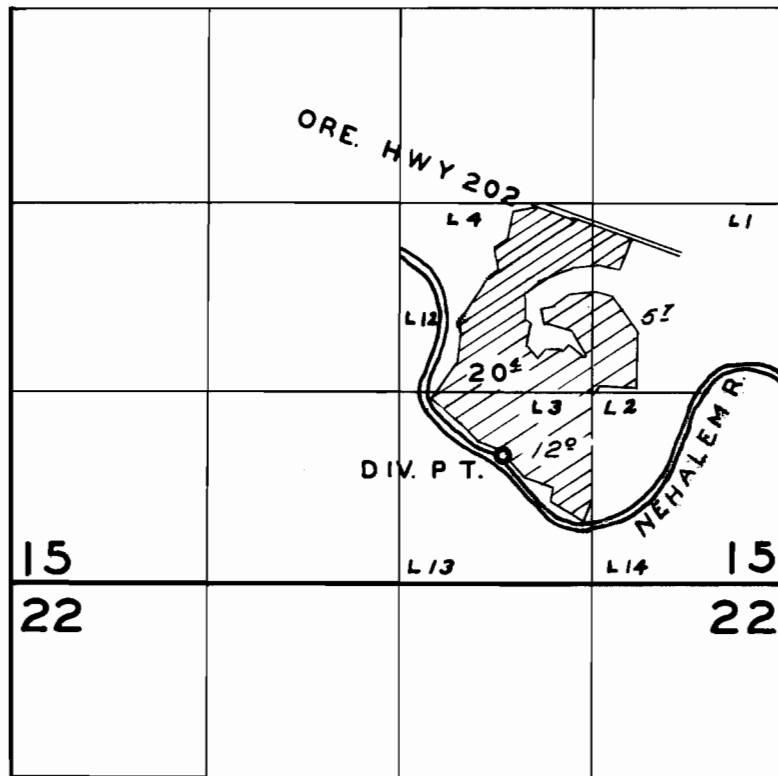

FINAL PROOF SURVEY
UNDER

Application No. 25951..... Permit No. 20346.....
IN NAME OF

SHALMON LIBEL

Surveyed AUG. 30. 1956, by R. H. WHITBY.....