


T. 4S. R. 3W. W.M.

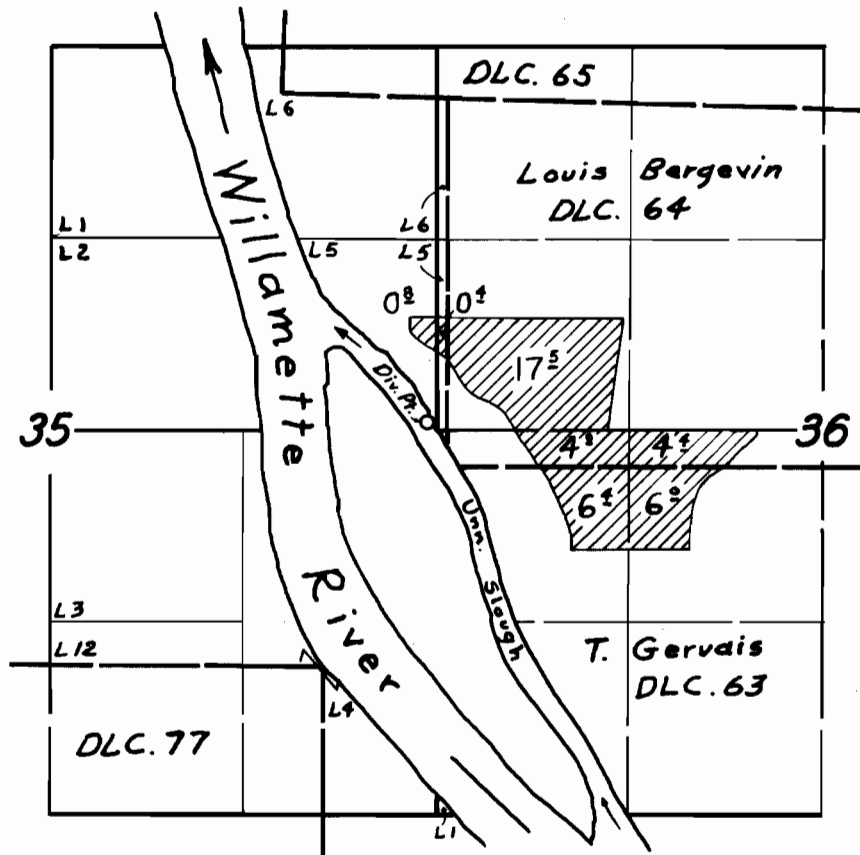

FINAL PROOF SURVEY
UNDER

Application No. 25993 Permit No. 20553
IN NAME OF

J. W. RICHARDSON

Surveyed 4 Sept. 1956, by M. Bish

DFN-3D-28

Rob