


T. 13 S. R. 34 E. W. W.

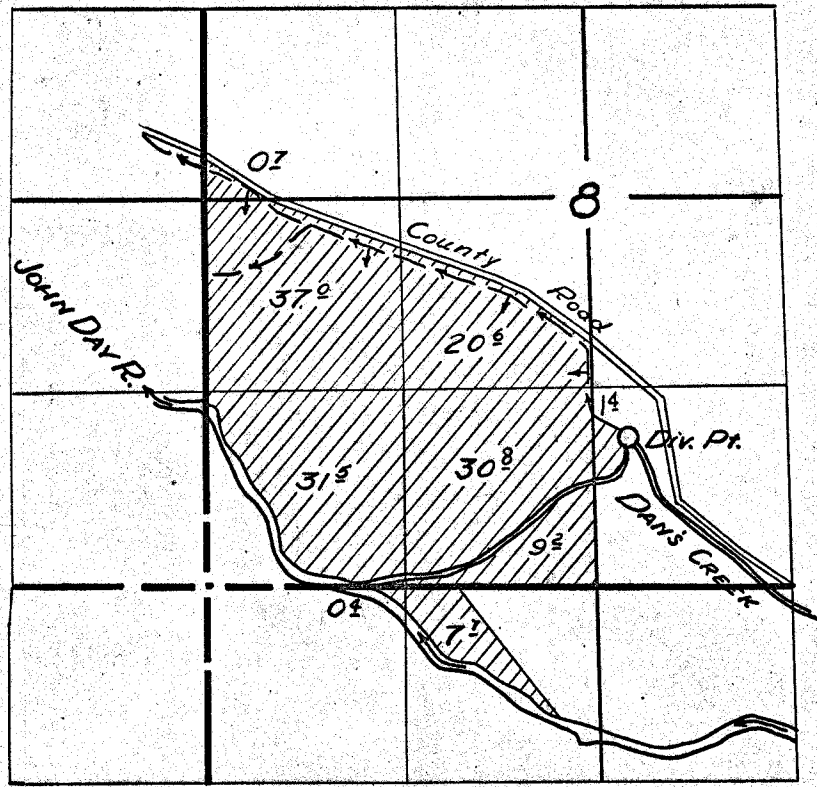

FINAL PROOF SURVEY
UNDER

Application No. 26008 Permit No. 20373
IN NAME OF

GEORGE T. MEADOR

Surveyed 20 Oct 1955, by [Signature]

1955-F