


T. 4S. R. 2W. W.M.

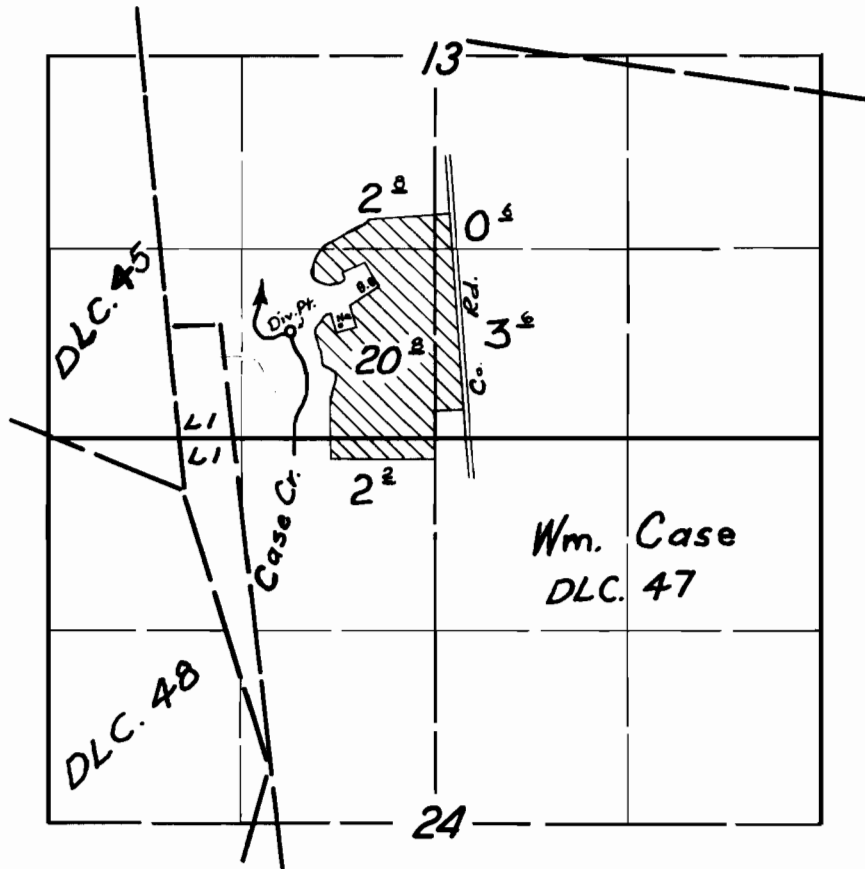

FINAL PROOF SURVEY

UNDER

Application No. 26048 Permit No. 20387

IN NAME OF

HAROLD J. ARENDT

Surveyed 21 Sept. 1956, by M. Bish