


T. 3S. R. 1W. W.M.

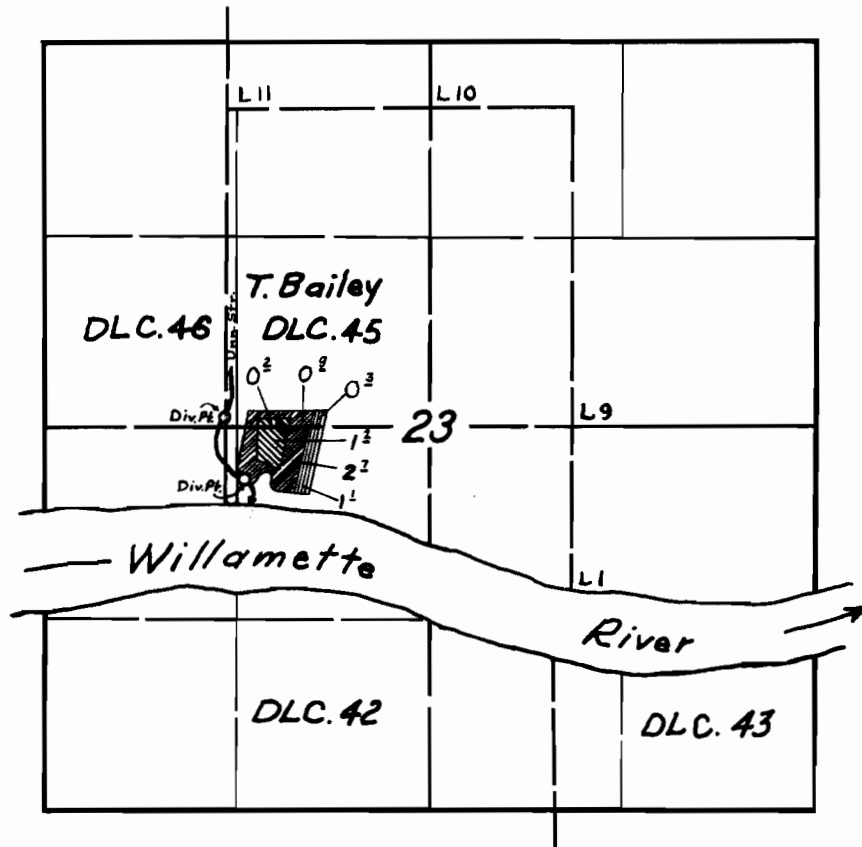

FINAL PROOF SURVEY

UNDER

Application No. 27741 26174 Permit No. 21817 20427

IN NAME OF

MARGUERITE THOMASON & RUBY D. NUTTING

Surveyed 26 June 1956, by M. Bish

Prim. - Suppl. -