


T.2 N. R.3 W. W.M.

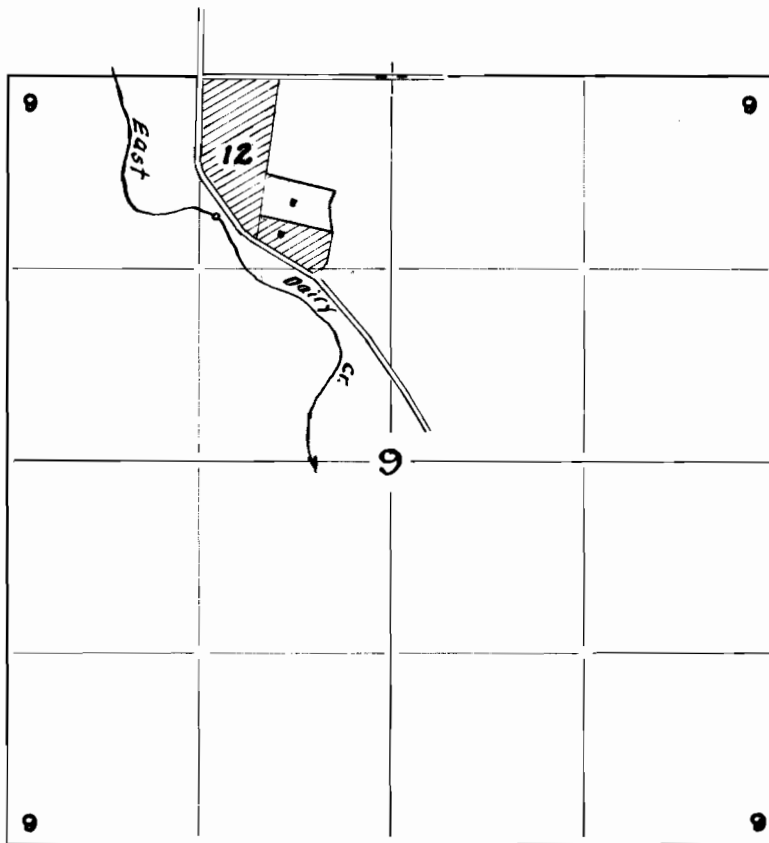

FINAL PROOF SURVEY

UNDER

Application No. 26356 Permit No. 20677

IN NAME OF

L. B. HOLLENBECK

Surveyed 4 - 11 1956 by R. H. WHITBY