


T.20&21S.R.46E.W.M.

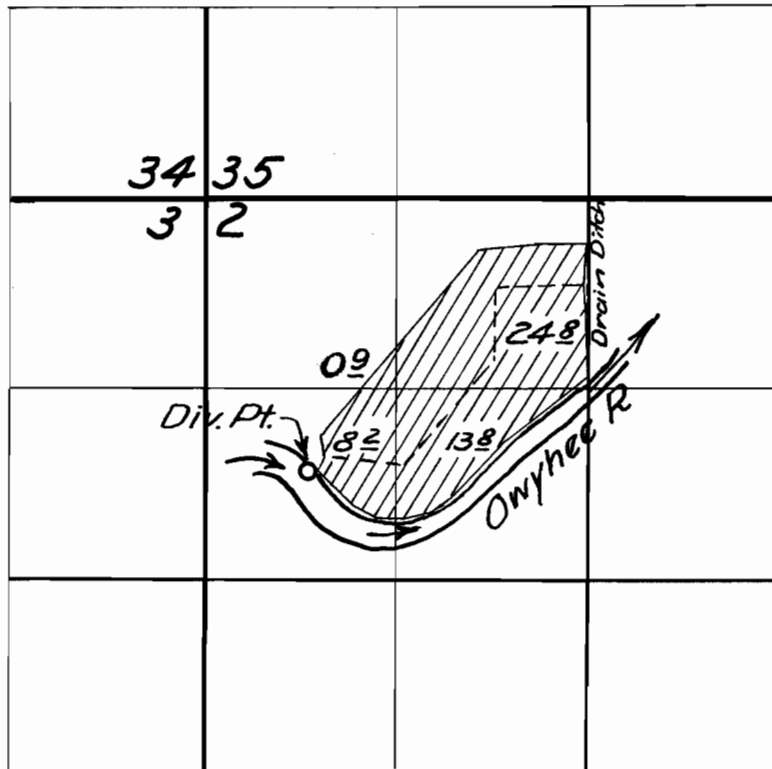

FINAL PROOF SURVEY
UNDER

Application No. 26528 Permit No. 20790
IN NAME OF

Eris L. & Willis J. Bertram

Surveyed Oct. 15 1955, by M. B. Bish

1955N