


T.13S.R.34E.W.M.

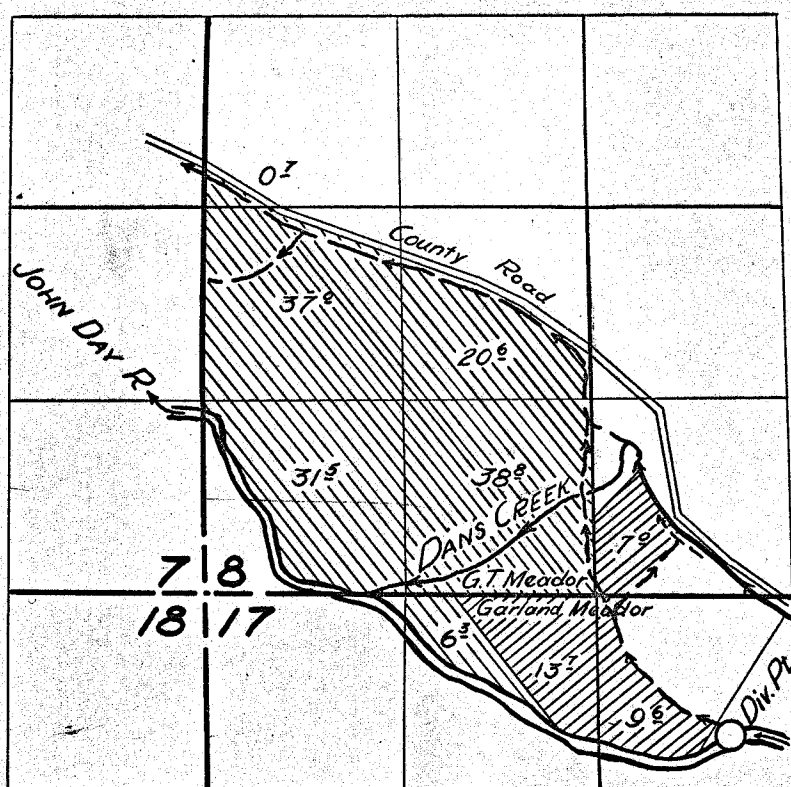

FINAL PROOF SURVEY
 UNDER

Application No. 26685 Permit No. 20892
 IN NAME OF

GEORGE T. & GARLAND MEADOR

Surveyed 20 Oct. 1955, by *[Signature]*