WR 78

HEYMAN - CAMPBELL FARMS IRRIGATION WORKS

SEC. 2 & 11, T. 11 S., R. 4 W., W. M.

SCALE: 1" = 10 CH. DEC. 22, 1951

ORRIS A. CARNEGIE
DEP. CO. SURVEYOR

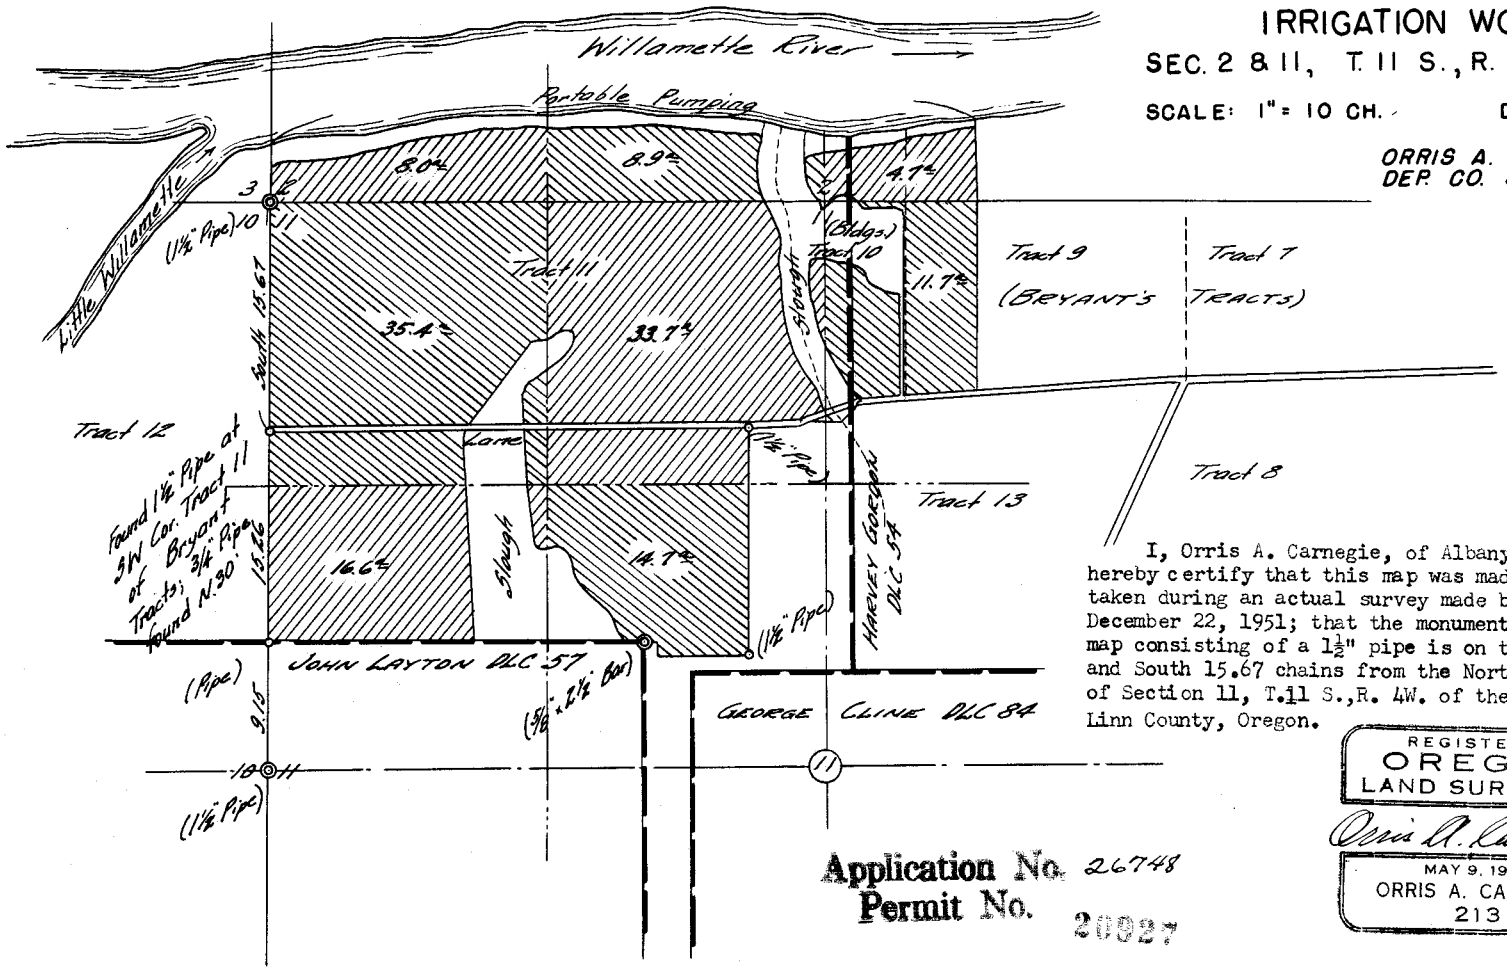

I, Orris A. Carnegie, of Albany, Oregon, do hereby certify that this map was made from notes taken during an actual survey made by me on December 22, 1951; that the monument shown on this map consisting of a 1½" pipe is on the West line of and South 15.67 chains from the Northwest corner of Section 11, T.11 S., R. 4W. of the Will. Mer. in Linn County, Oregon.

REGISTERED
OREGON
LAND SURVEYOR

Orris A. Carnegie

MAY 9, 1947
ORRIS A. CARNEGIE
213

Application No. 26748
Permit No. 20927