


T. 3 N. R. 2 W. W. M.

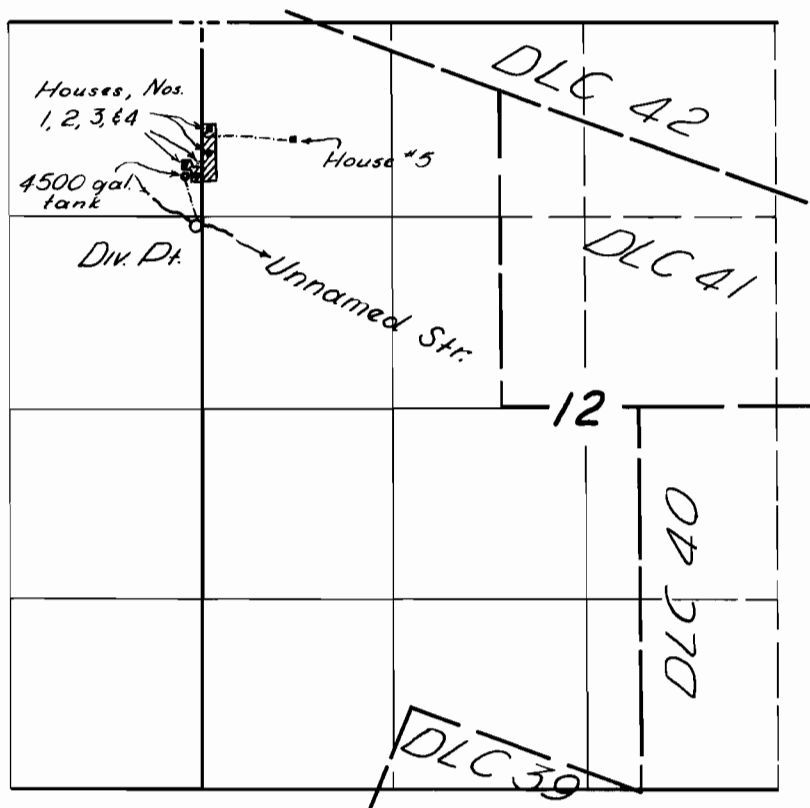

FINAL PROOF SURVEY

UNDER

Application No. 26888 Permit No. 21110

IN NAME OF

JEAN HEBEISEN

Surveyed 5 Aug 1956, by [Signature]