


T. 3S. R. 2E. W.M.

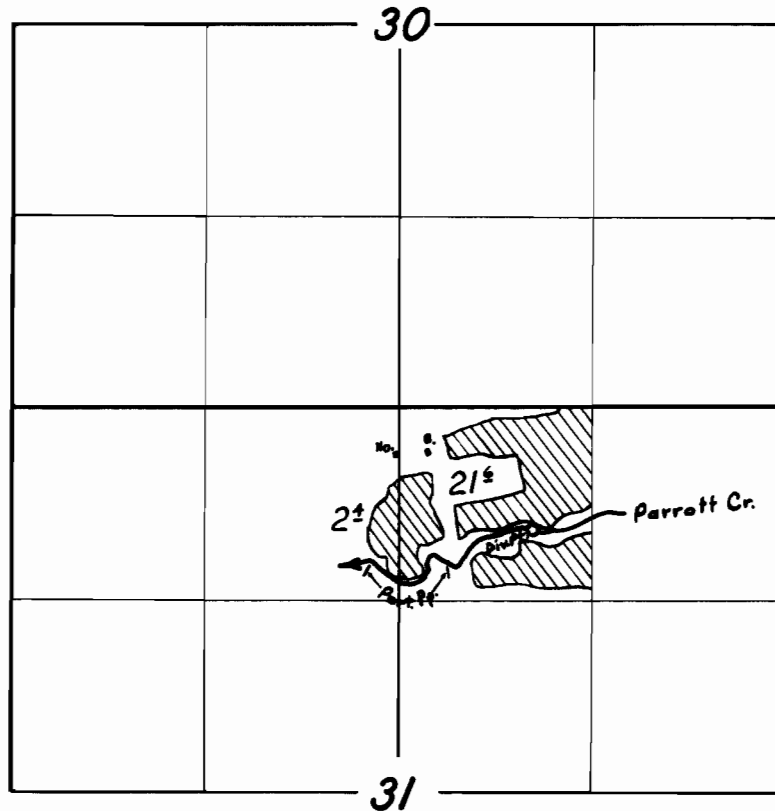

FINAL PROOF SURVEY

UNDER

Application No. 23772 Permit No. 18879

IN NAME OF

ELDRED A. THIEL

Surveyed 27 June 1956, by M. Bish

DFK-3D-125

RT