


T. 2 S. R. 1 W. W.M.

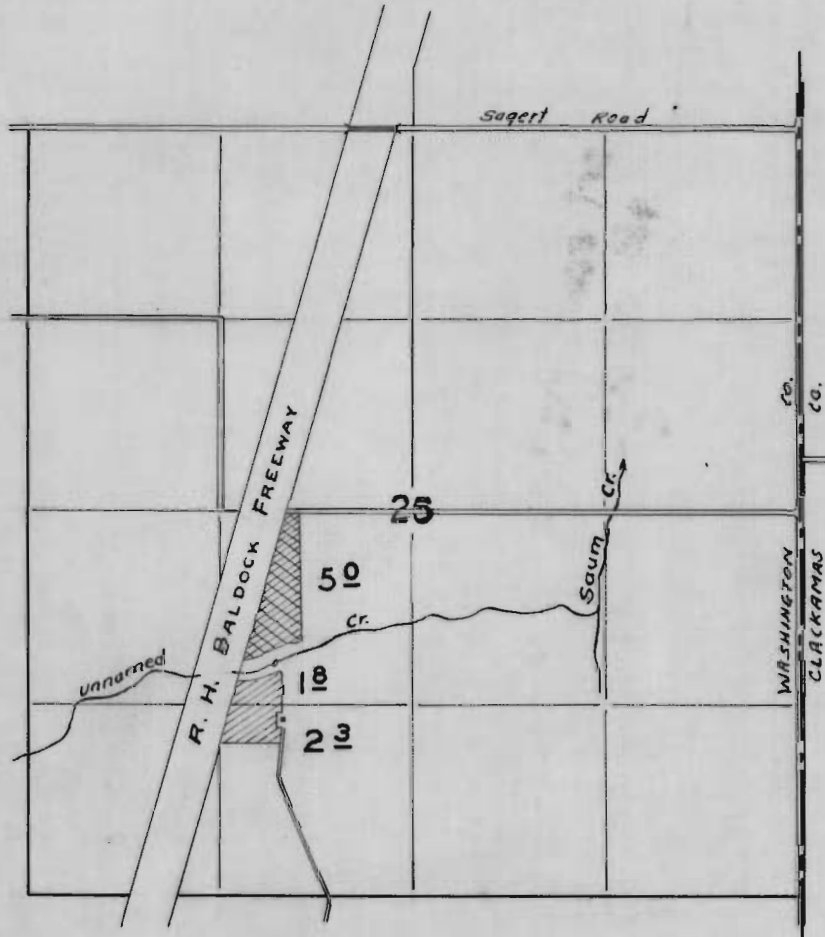


FINAL PROOF SURVEY

UNDER

Application No. 27044 Permit No. 21282

IN NAME OF
FRANK & SABATINA SQUICCIARINI
GLENN D. WARK

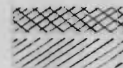

Surveyed 5 - 7 1956 by R.H. WHITBY