


T.2S.,R.1E.,W.M.

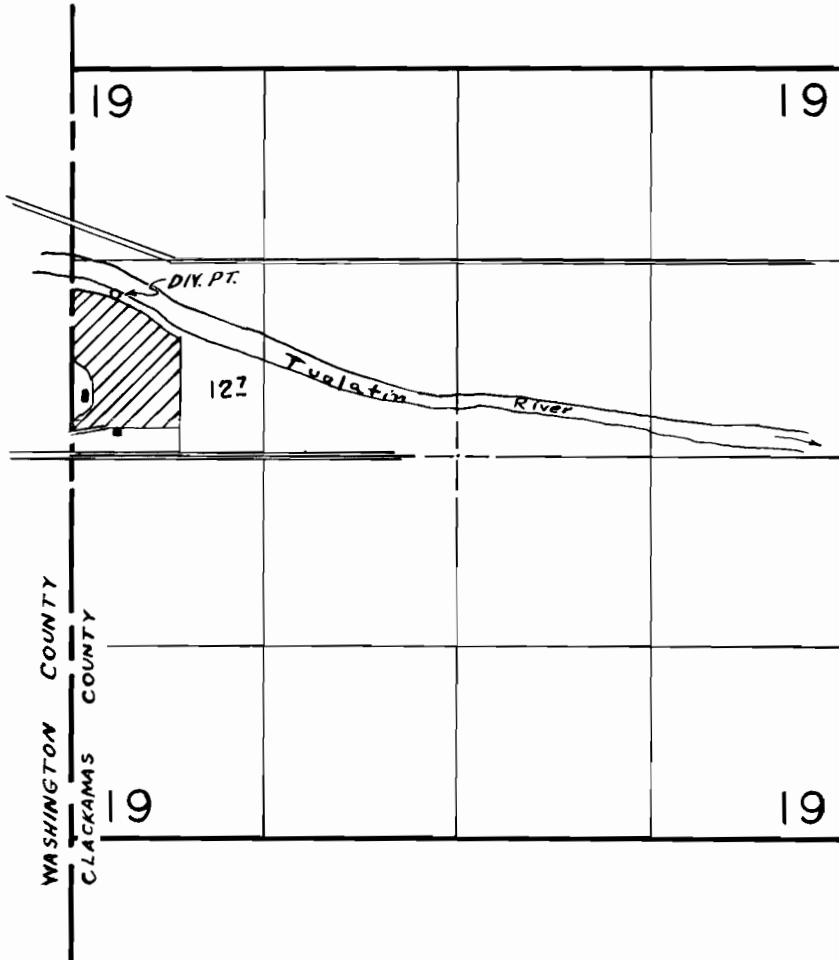

FINAL PROOF SURVEY

UNDER

Application No. 27173 Permit No. 21370

IN NAME OF

WM. F. LACEY

Surveyed 5-10-56 by R.D. BEST