


T. 5&6S. R. 2W. W.M.

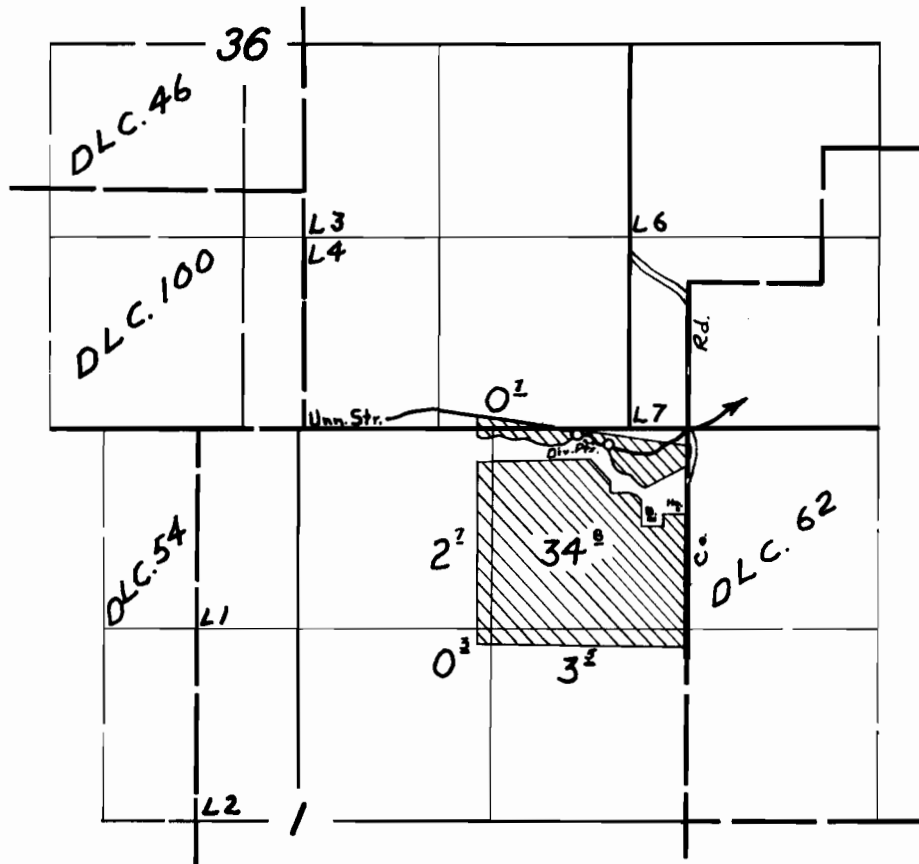

FINAL PROOF SURVEY

UNDER

Application No. 27360 Permit No. 21541

IN NAME OF

CARL PRANTL

Surveyed 16 July 1956, by M. Bish

DFN-2D-105

EB