


T.2S. R.1W. W.M.

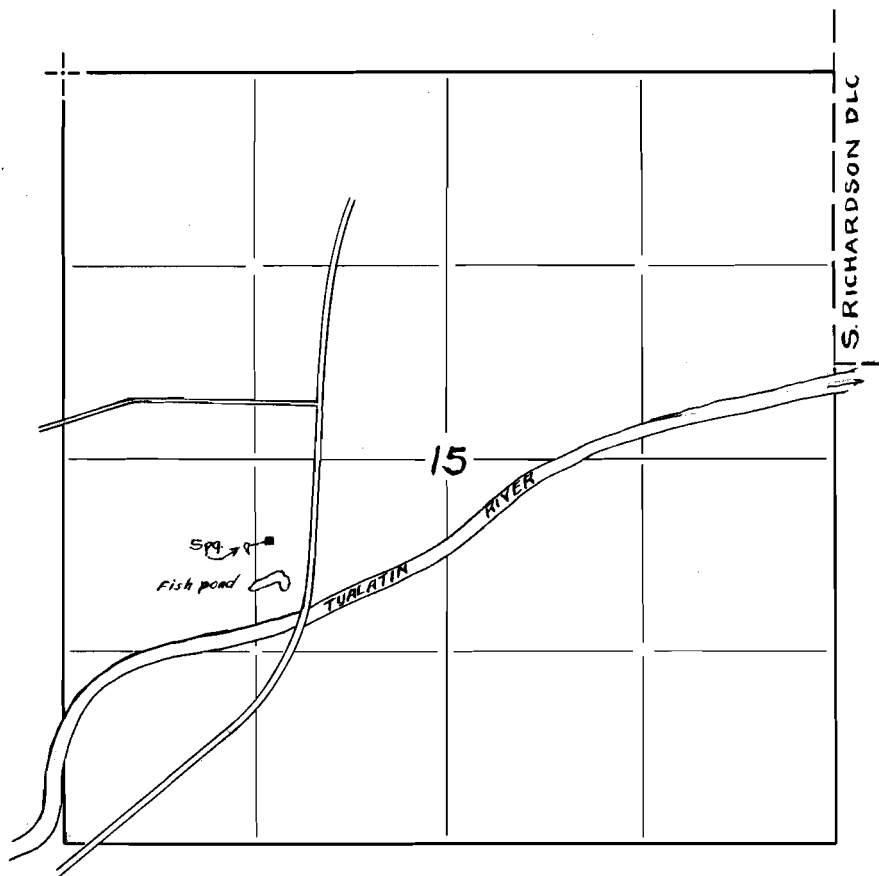

FINAL PROOF SURVEY

UNDER

Application No. 275.23 Permit No. 21683
IN NAME OF

PHILLIP H. WILLS

Surveyed 5 - 8 1956, by R.H. WHITBY