


13052 to 1/4 Cor bet 26+35

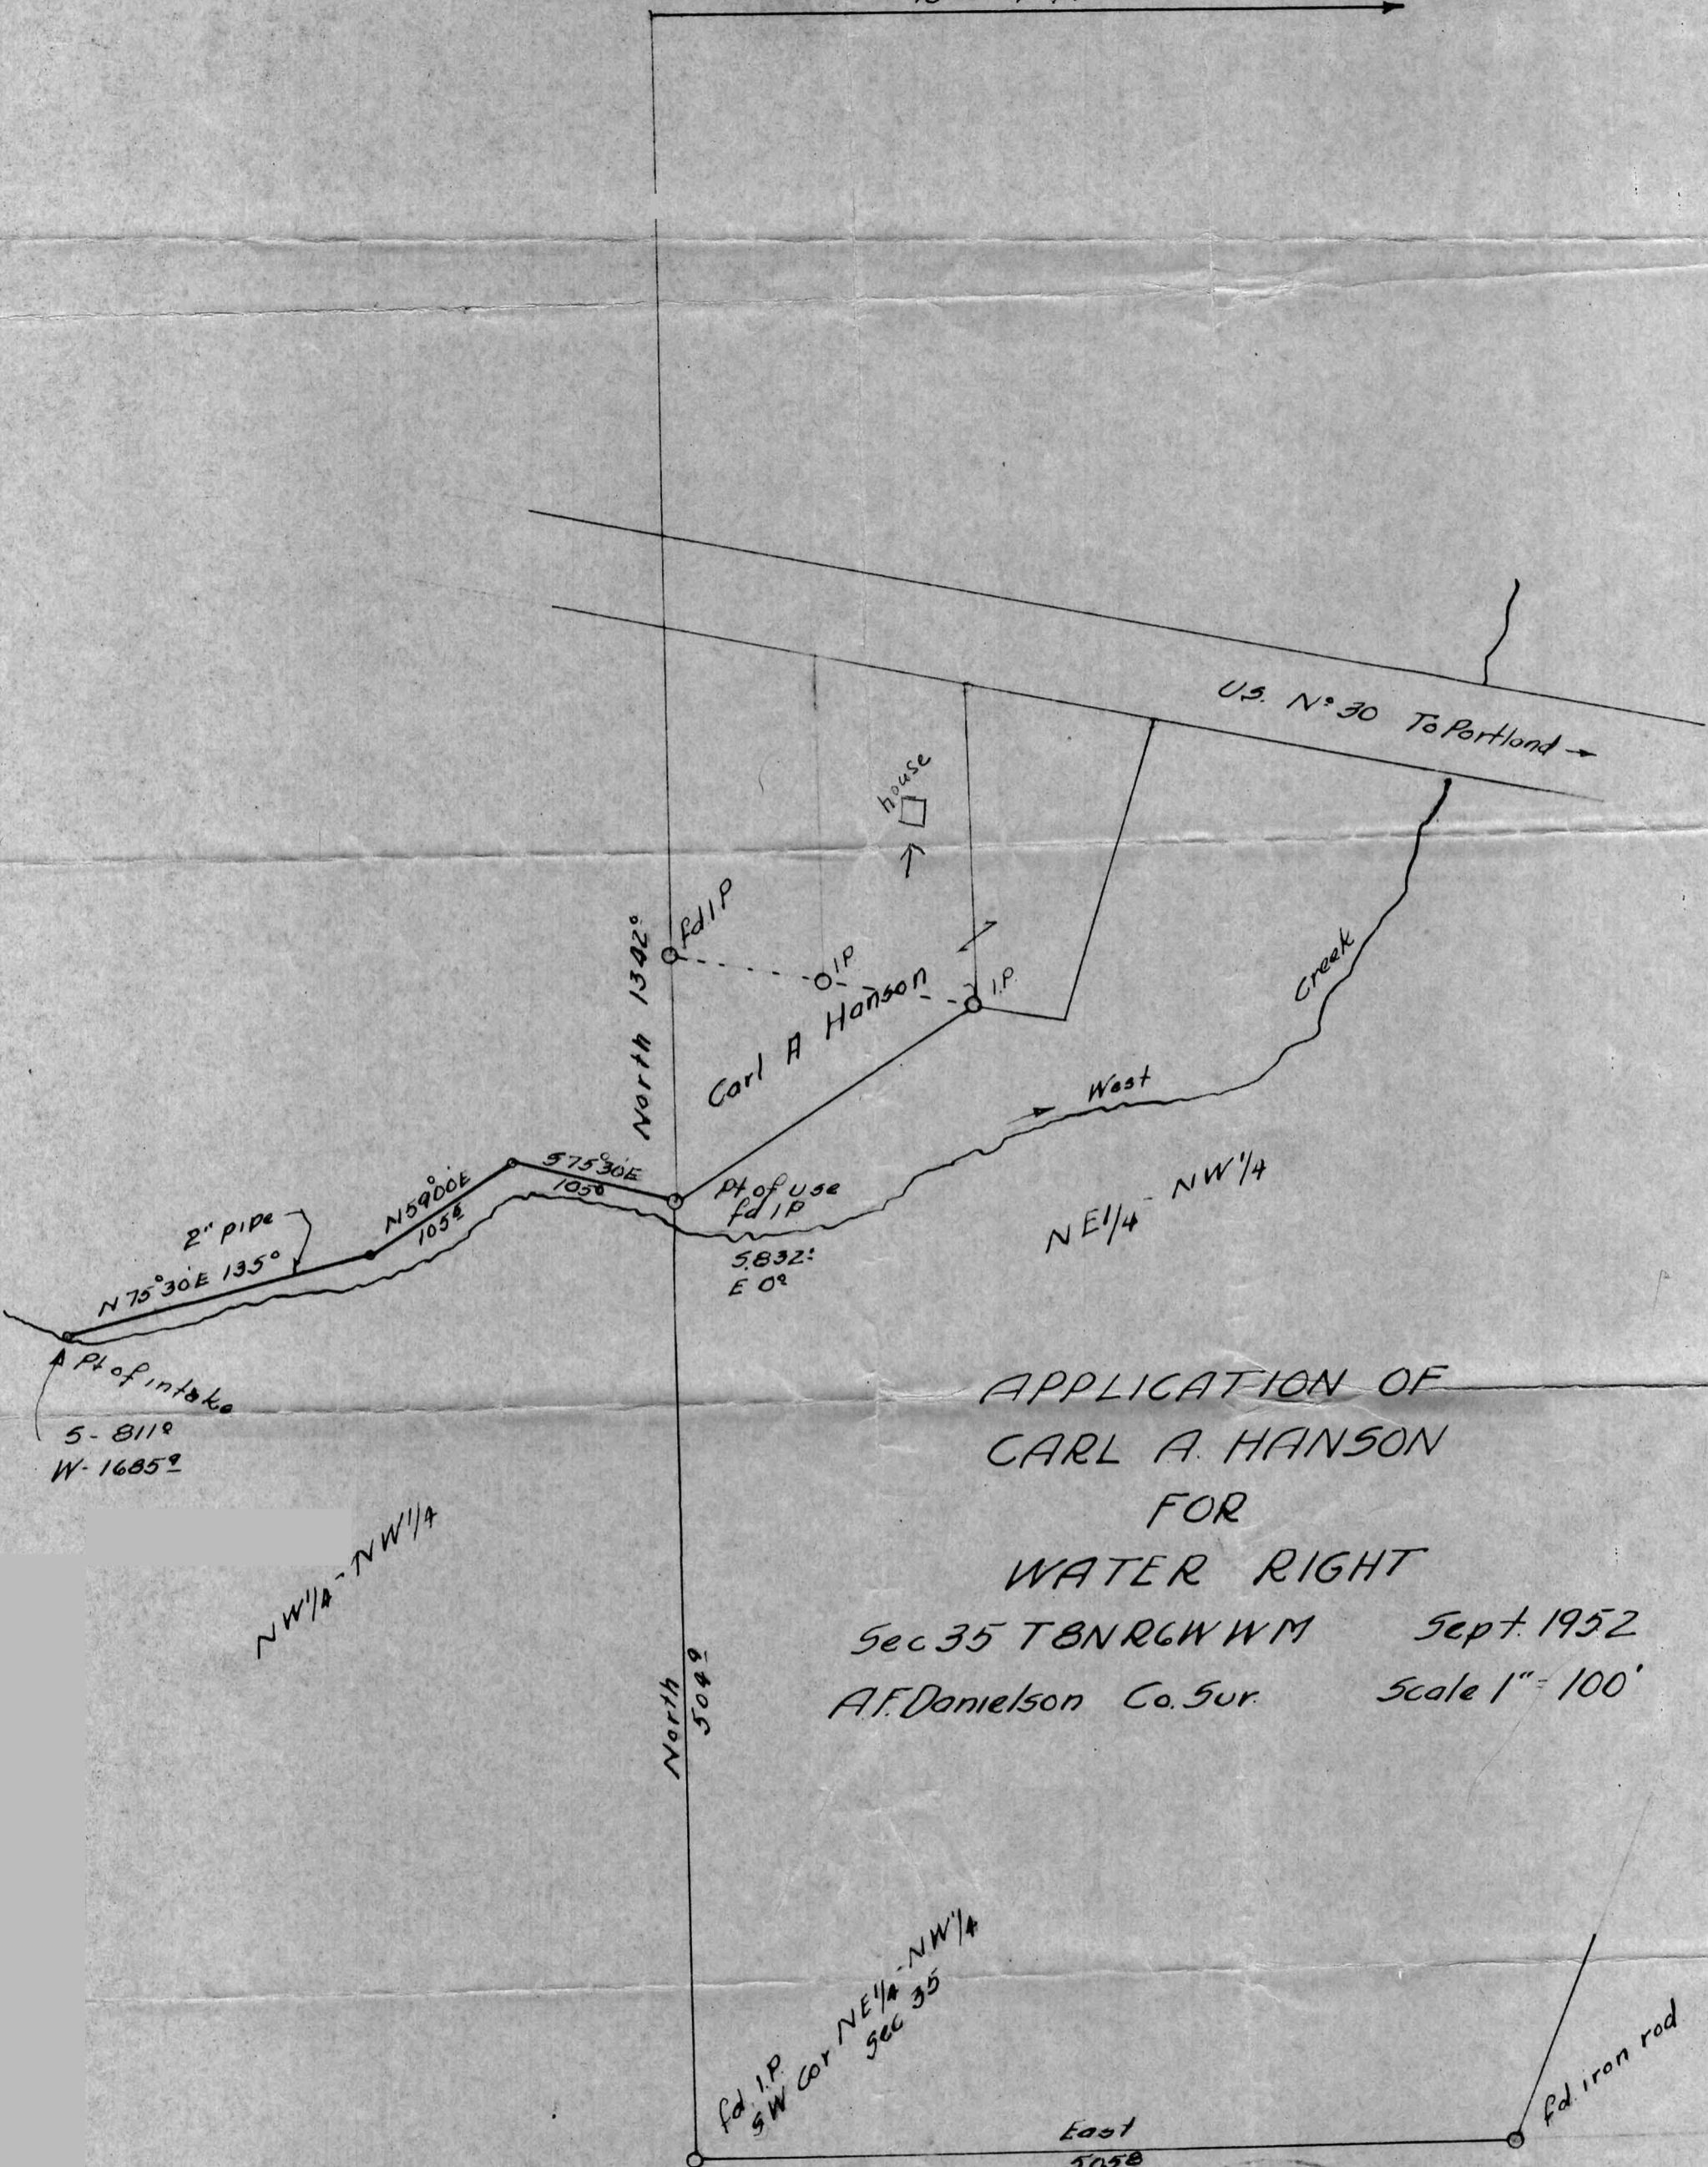

APPLICATION OF
 CARL A. HANSON
 FOR
 WATER RIGHT

Sec 35 T8N R6W W1M Sept. 1952
 A.F. Danielson Co. Sur. Scale 1" = 100'

RECEIVED
 OCT 17 1952
 STATE ENGINEER
 SALEM, OREGON

RECEIVED
 SEP 4 1952
 STATE ENGINEER
 SALEM, OREGON

REGISTERED PROFESSIONAL
 ENGINEER
 823
Guthrie Danielson
 OREGON
 DEC 31 1959

App. 27626
 Per 21760