


T. 3S. R. 3E. WM.

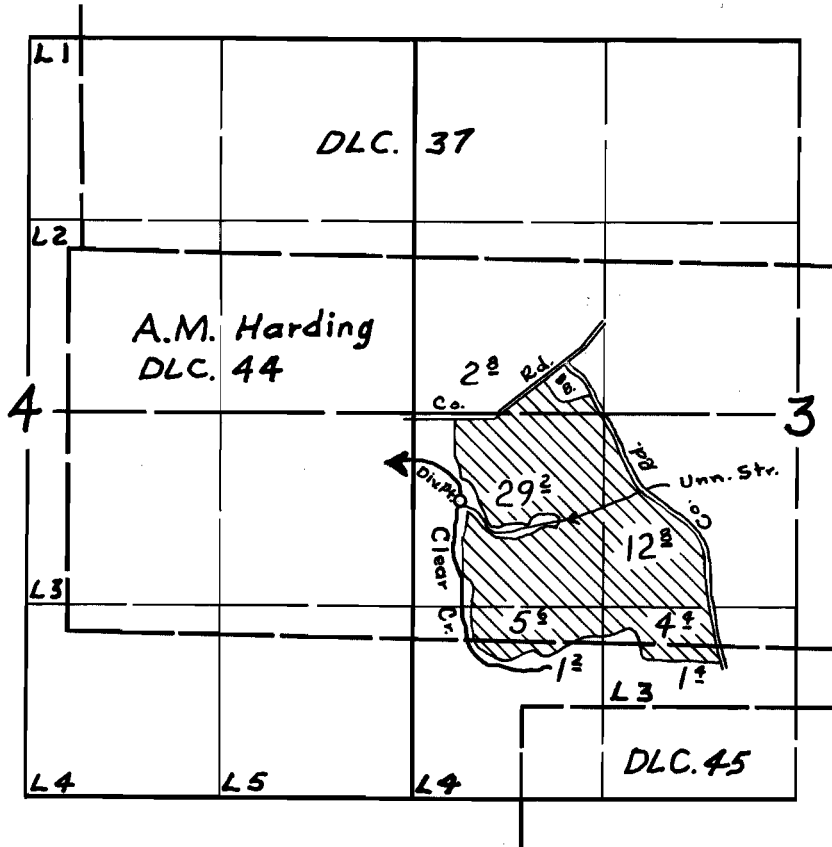

**FINAL PROOF SURVEY**  
UNDER

Application No. 27703 Permit No. 21808  
IN NAME OF

L. E. Hinkson

Surveyed 29 Aug. 1956, by M. Bish

DFK-1D-131

131