


T. 3 S. R. 2 W. W. M.

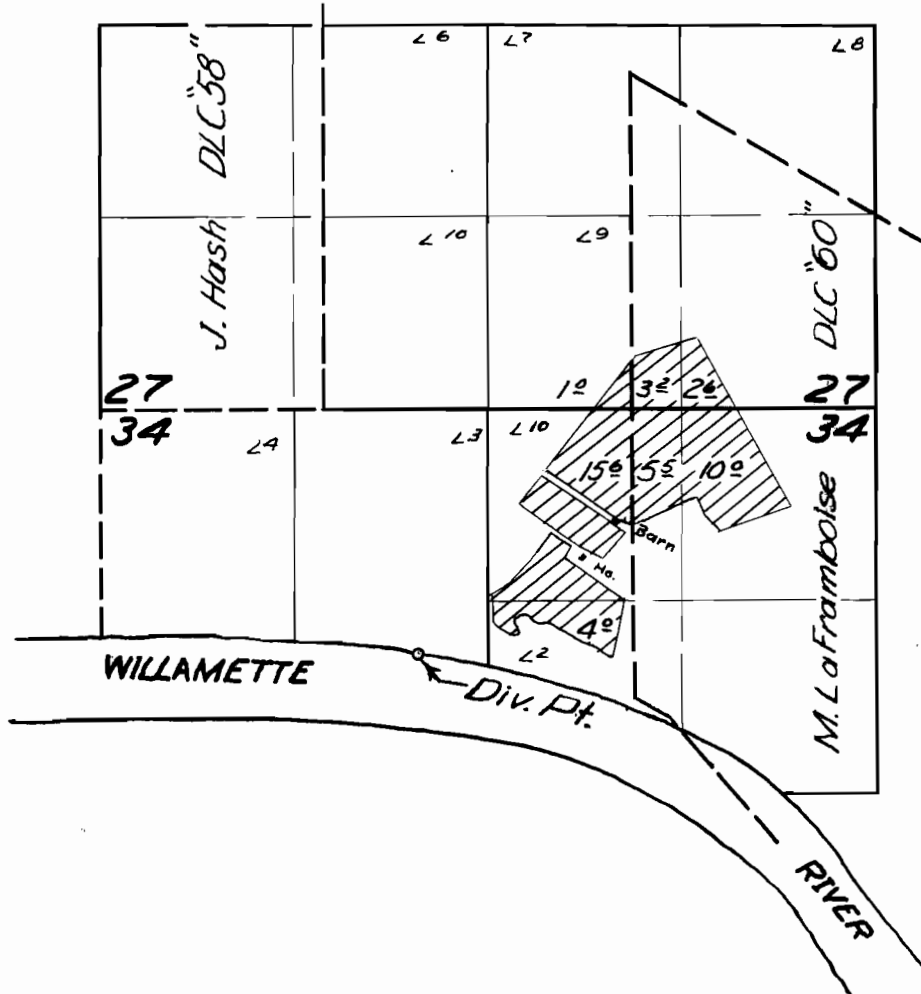

FINAL PROOF SURVEY
UNDER

Application No. 28509 Permit No. 22318
IN NAME OF

C. M. Bishop

Surveyed Mar. 19 1956 by Tr. Bishop

DFQ-2D-35