


T. 6S. R. 18&2W. W.M.

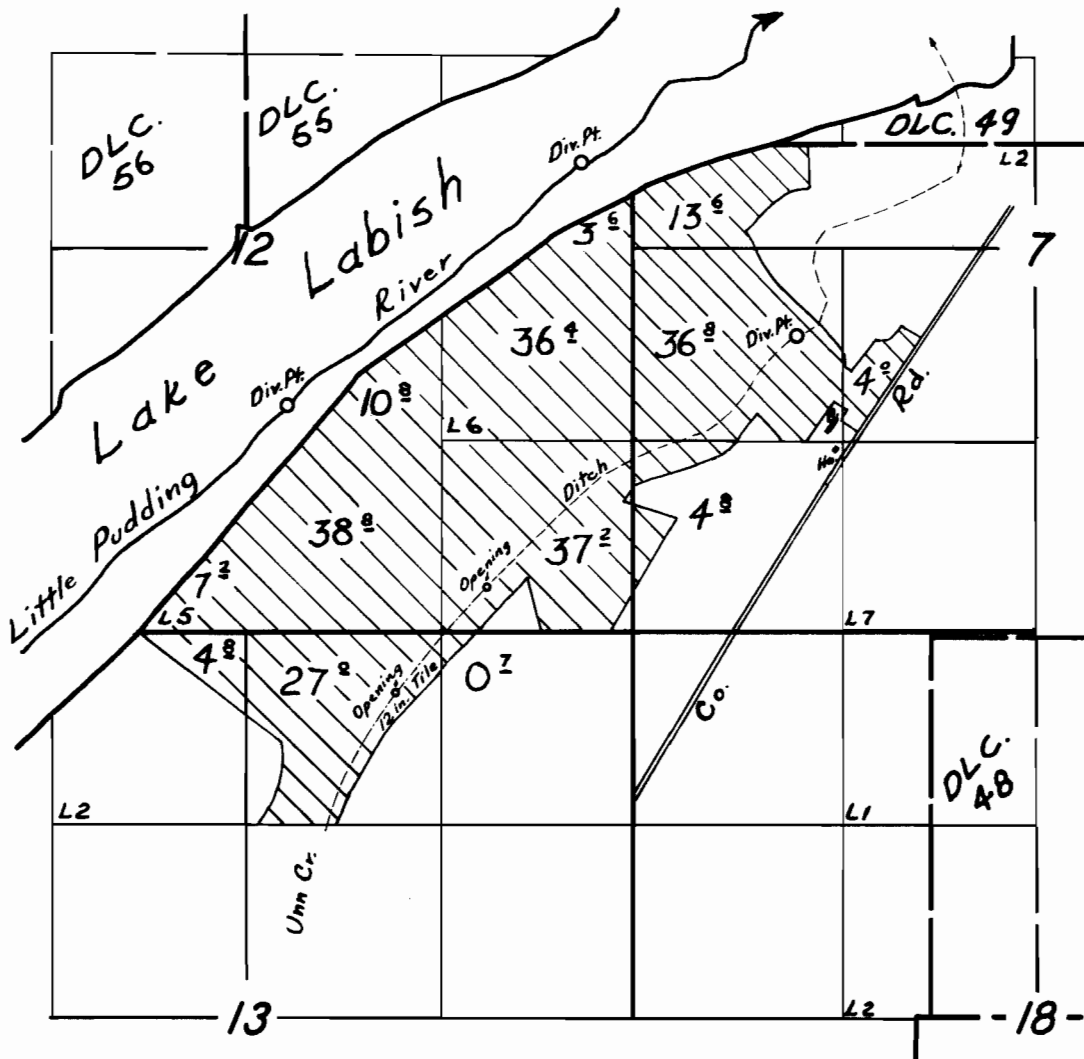

FINAL PROOF SURVEY

UNDER

Application No. 28465 Permit No. 22496

IN NAME OF

JAMES JACKSON

Surveyed 24 Aug. 1956, by M. Bish

DFN-2D-107