


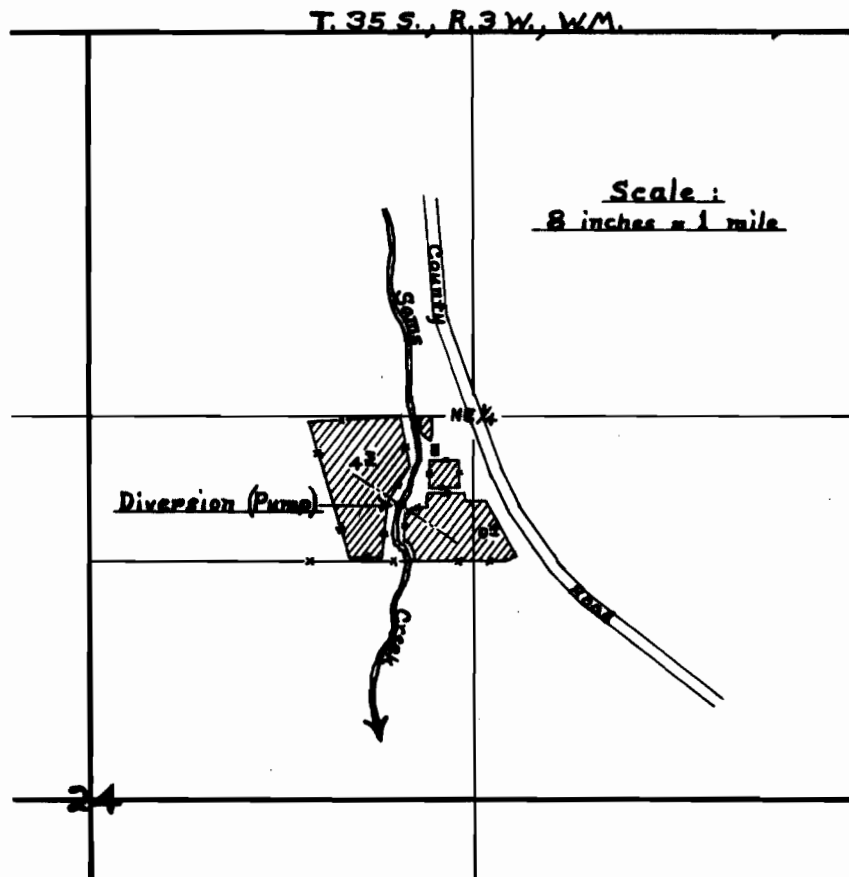

FINAL PROOF SURVEY UNDER

Application No. 22786 Permit No. 22659
IN NAME OF

Alfred J. Gower

Surveyed March 26 1957, by D.C. Hendrix, W.M.