


T. 3 N. R. 2 W. W.M.

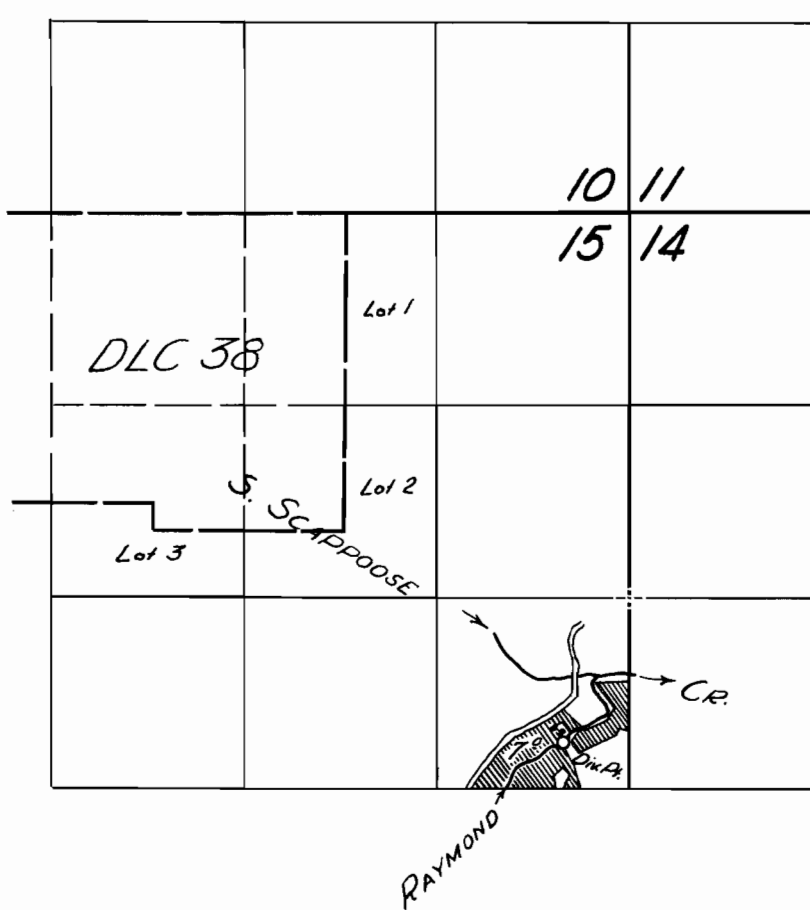

FINAL PROOF SURVEY
UNDER

Application No. 28878 Permit No. 22708
IN NAME OF

F. F. CARTER

Surveyed 31 July 1956, by [Signature]