


T.14 S.R. 39 E.W.M.

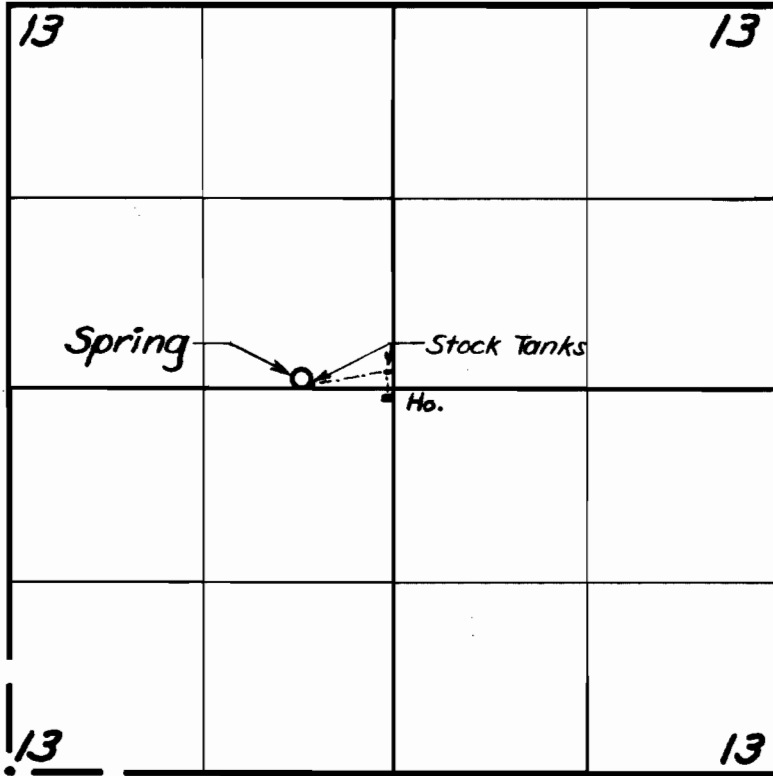

**FINAL PROOF SURVEY**

UNDER

Application No. 30144 Permit No. 24494  
IN NAME OF

Ernest & Fred Lacey

Surveyed Nov. 2 1955, by M. Rich