


T.1&2N. R.4&5W. W.M.

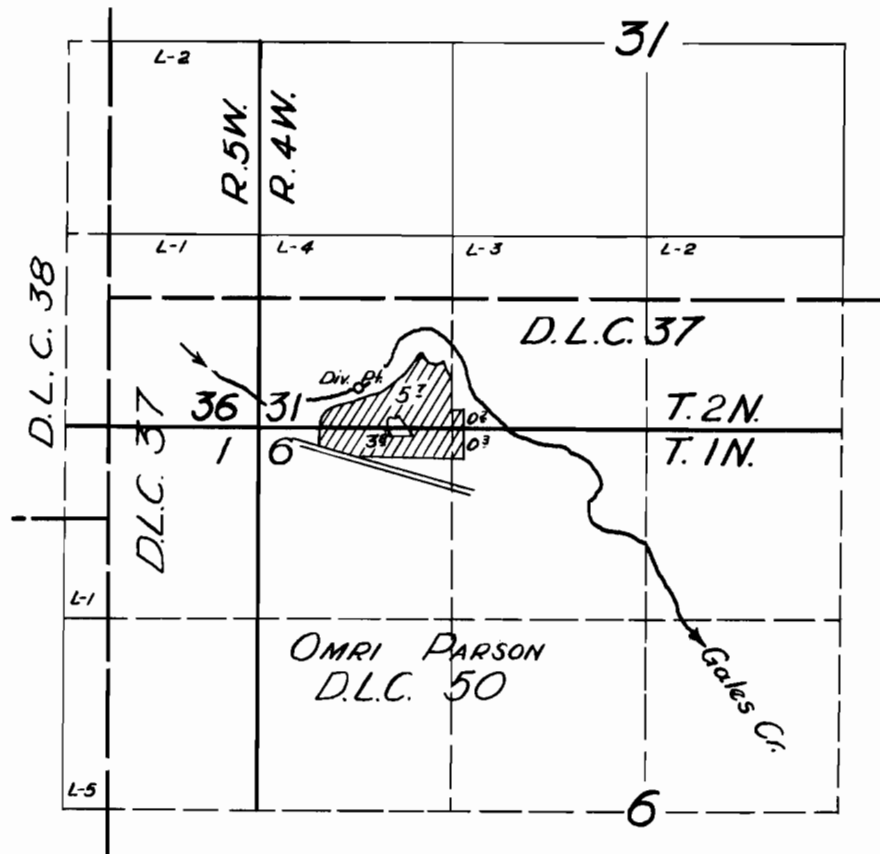

FINAL PROOF SURVEY

UNDER

Application No. 23807 Permit No. 18883

IN NAME OF

HOWARD SAXTON

Surveyed 7-14 1952, by H.L. Coffman