


T.1&2 N., R.4&5 W., W.M.

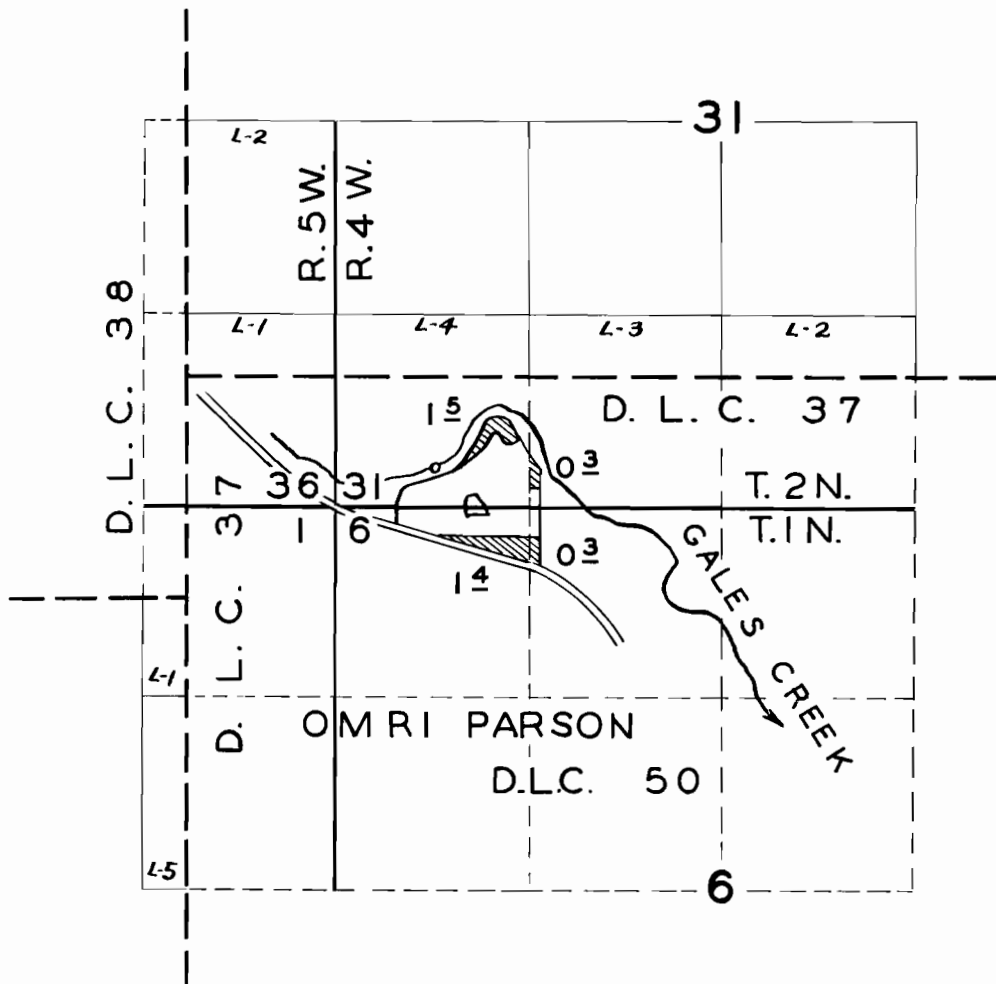

**FINAL PROOF SURVEY**


UNDER

Application No. 2709 | Permit No. 21411  
IN NAME OF

HOWARD SAXTON

Surveyed 4-12 1956, by R.D. BEST

T1&2N, R4W, WM

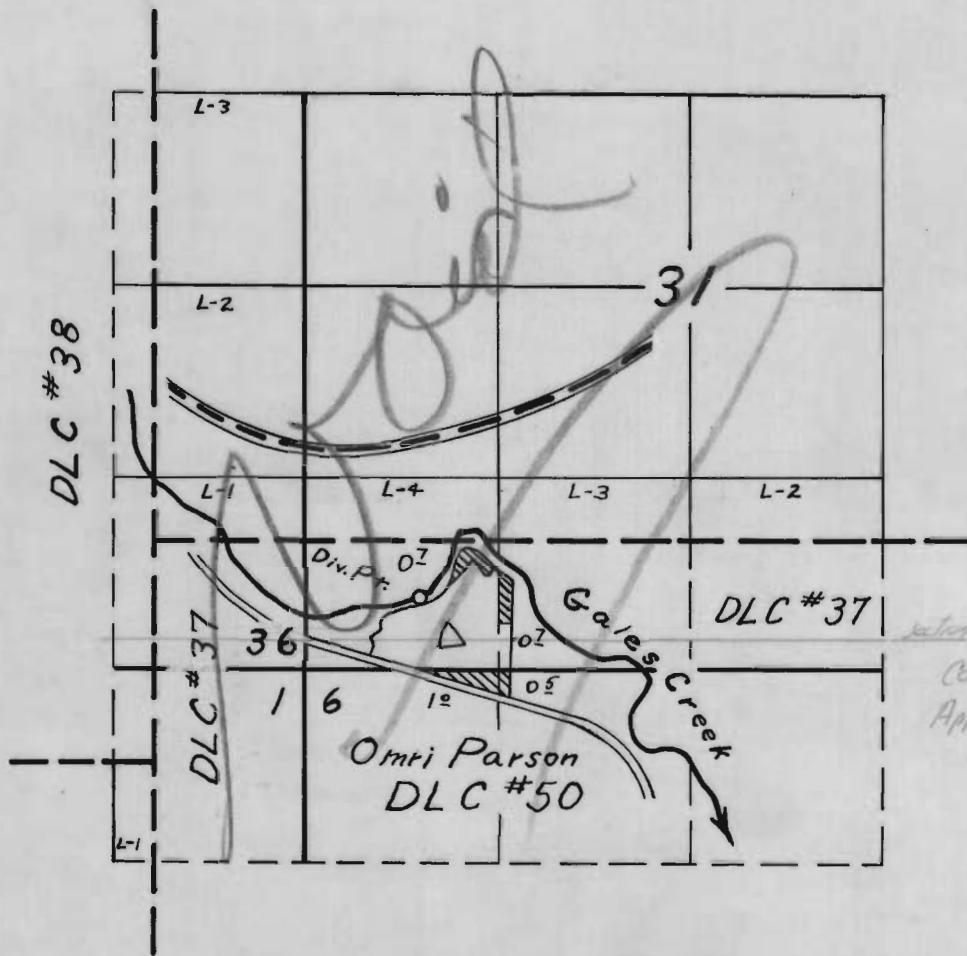

**FINAL PROOF SURVEY**  
UNDER

Application No. 27091 Permit No. 21411  
IN NAME OF

Surveyed 4-12 1956, by R.D. Best