


T. 1 S., R. 2 W. W.M.

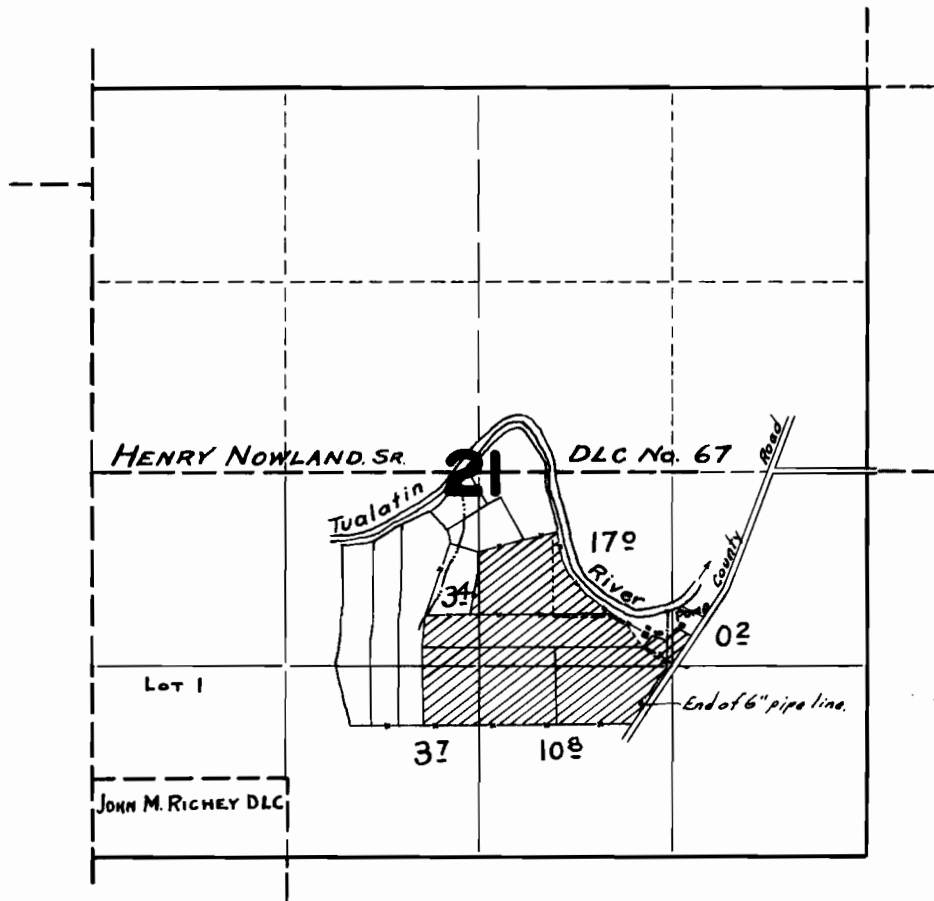

**FINAL PROOF SURVEY**  
UNDER

Application No. 17039 Permit No. 12786

IN NAME OF

Frank Setniker

Surveyed Aug. 4, 1942, by Geoff Spademan