


# T.1 S.R.2W.W.M.

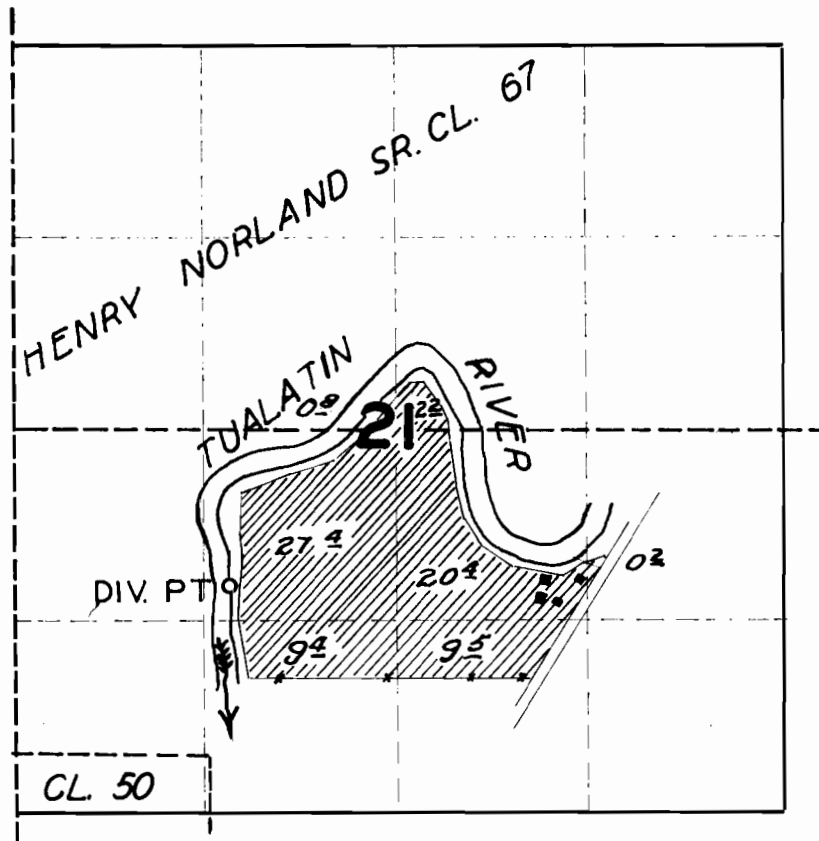

## FINAL PROOF SURVEY

UNDER

Application No. 24380. Permit No. 19234.

IN NAME OF

L. F. SETNIKER

Surveyed 7/10 1951, by H. L. COFFMAN.