


T.1 S. R.3 W. W.M.

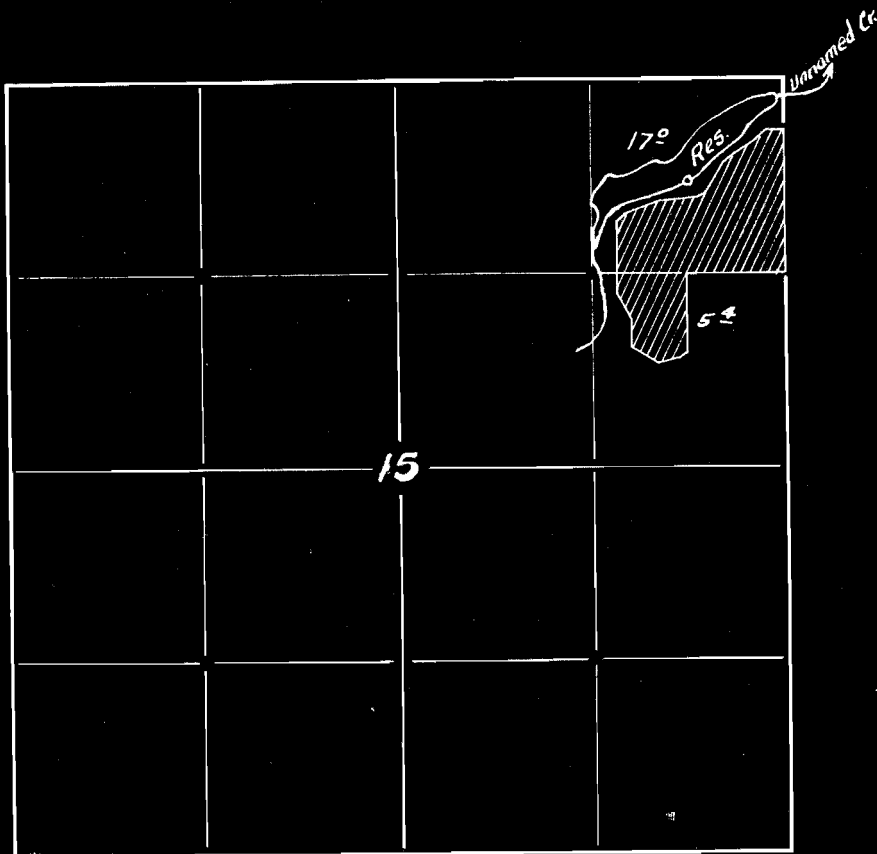

FINAL PROOF SURVEY

R - 26962 UNDER R-1356
27420 21306

Application No. 24866 Permit No. 19566

IN NAME OF

FRED C. MEYER

Surveyed 4-27, 1956, by R.H. WHITBY.