


T.2 N. R.4 W. W.M.

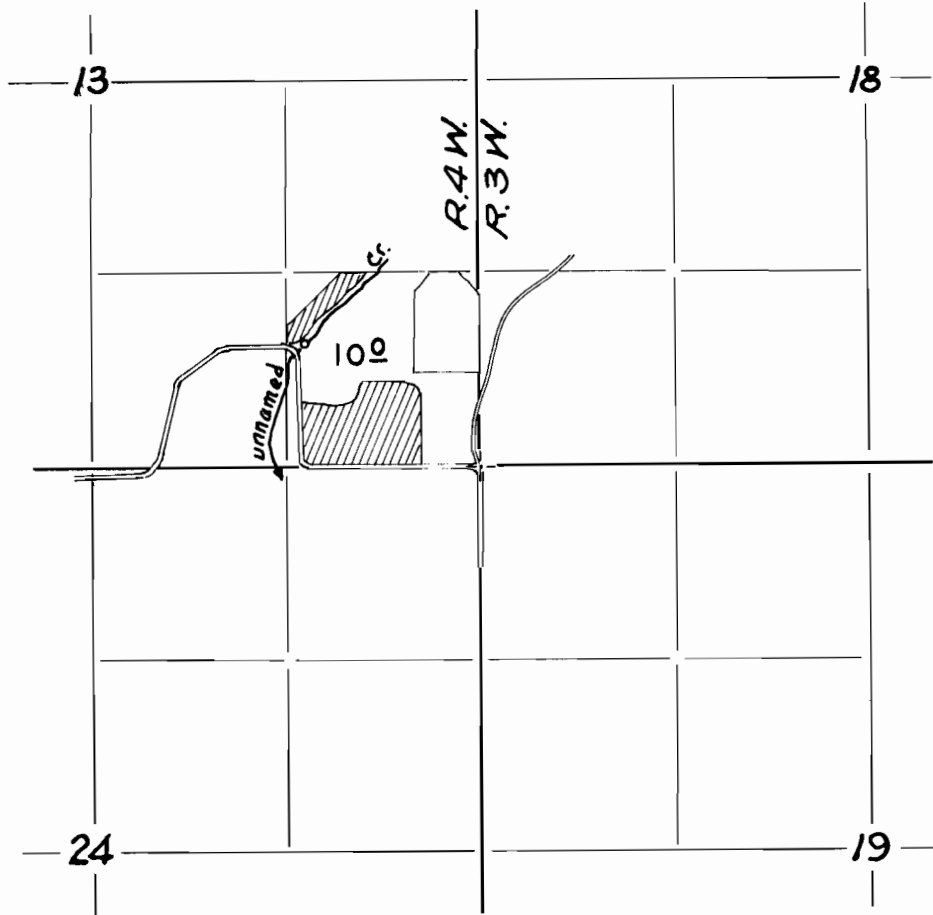

FINAL PROOF SURVEY

UNDER

Application No. 26578 Permit No. 20860

IN NAME OF

VERNON B. BATEMAN

Surveyed 4-12-1956 by R.H. WHITBY