



T.1S.R.3W.W.M.

3

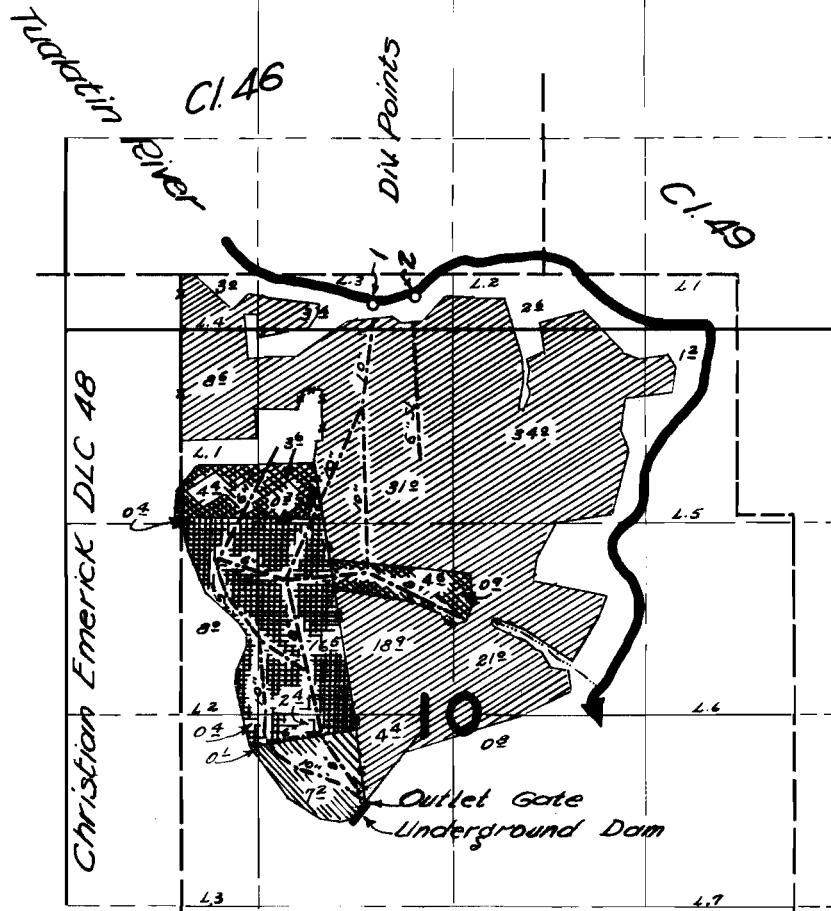

J.B Galloway
M.H. Kraemer
E.A. Scholz

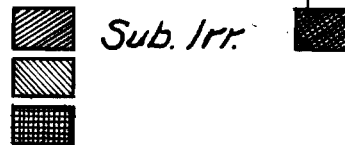

FINAL PROOF SURVEY

UNDER

Application No. 16518... Permit No. 12315...

IN NAME OF

E.A. Scholz & Wm. & Hildegard Pletz

Surveyed 7-22-1952, by *H.L. Coffman*