


T. 4S. R. 3E. W.M.

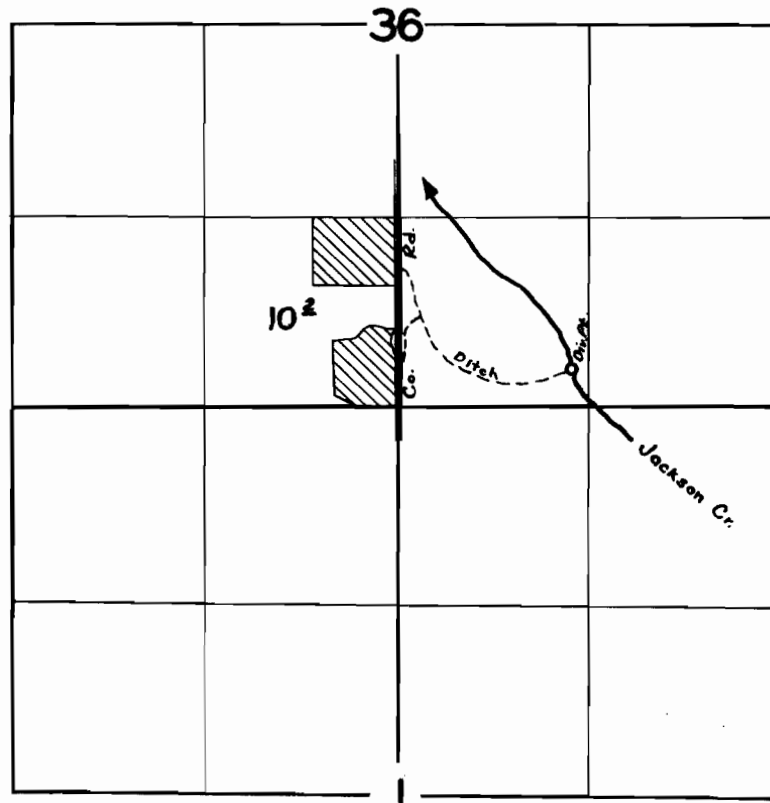

FINAL PROOF SURVEY

UNDER

Application No. 17216 Permit No. 12937

IN NAME OF

Estate of Olaf Rask

Surveyed 3 APR. 1956, by R.D. BEST

DFK - ID - 196

200