


T. 9 S. R. 3 W. W. M.

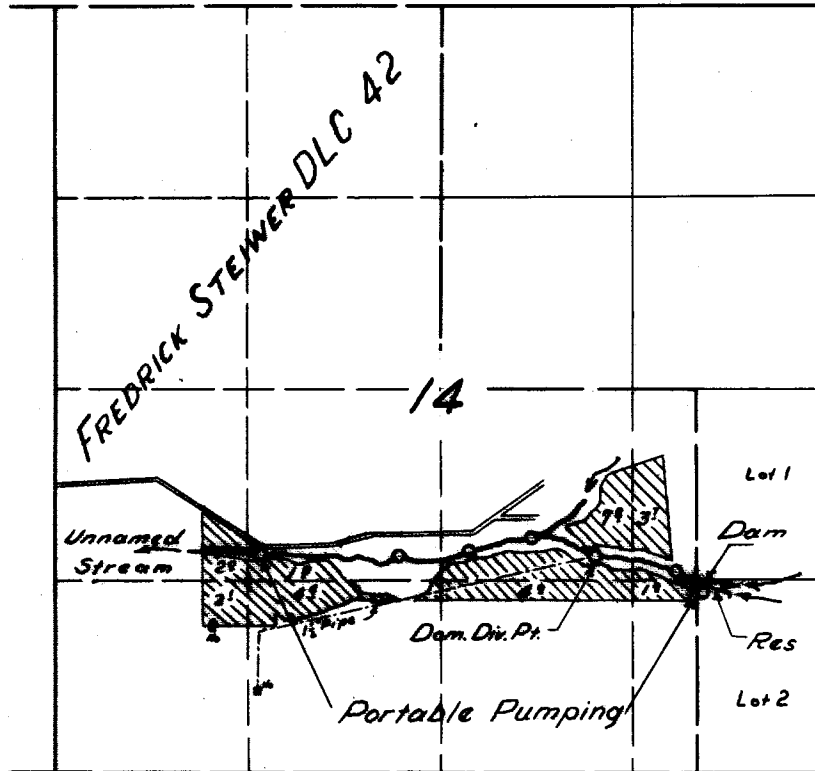

FINAL PROOF SURVEY

UNDER

R-22915

R-916

Application No. 22916 Permit No. 18066

IN NAME OF

KARL STEIWER

Surveyed 17 May 1956, by *[Signature]*