


T. 7 S. R. 3 W. W.M.

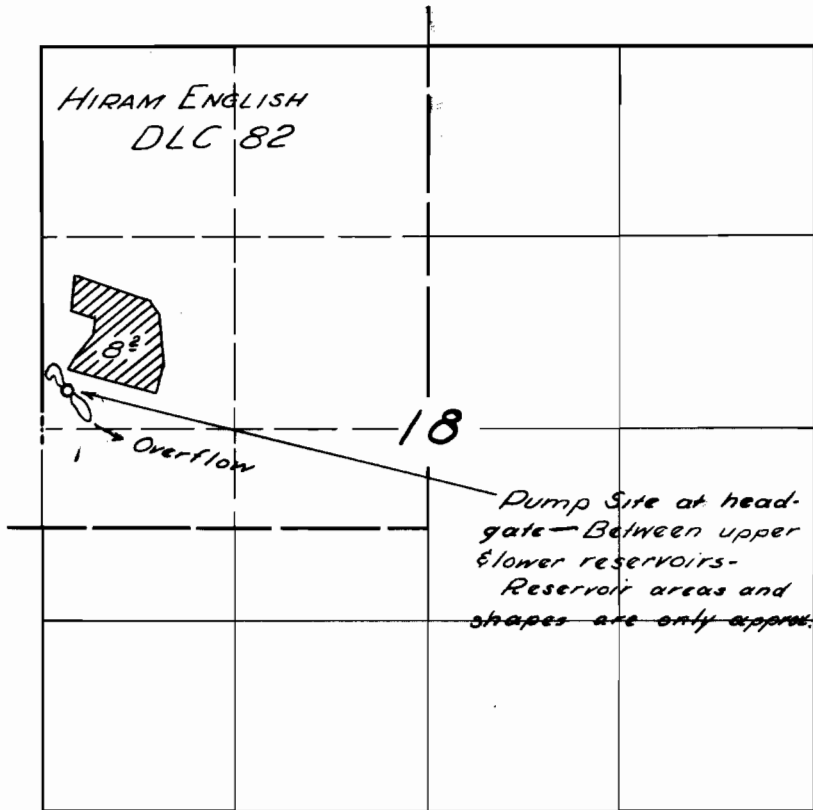

FINAL PROOF SURVEY

UNDER

R-24144

R-1012

Application No. 24145 Permit No. 19200

IN NAME OF

CARL R. STAATS

Surveyed 4 Sept. 1956, by [Signature]