


T.32 & 33S. R.42E.W.M.

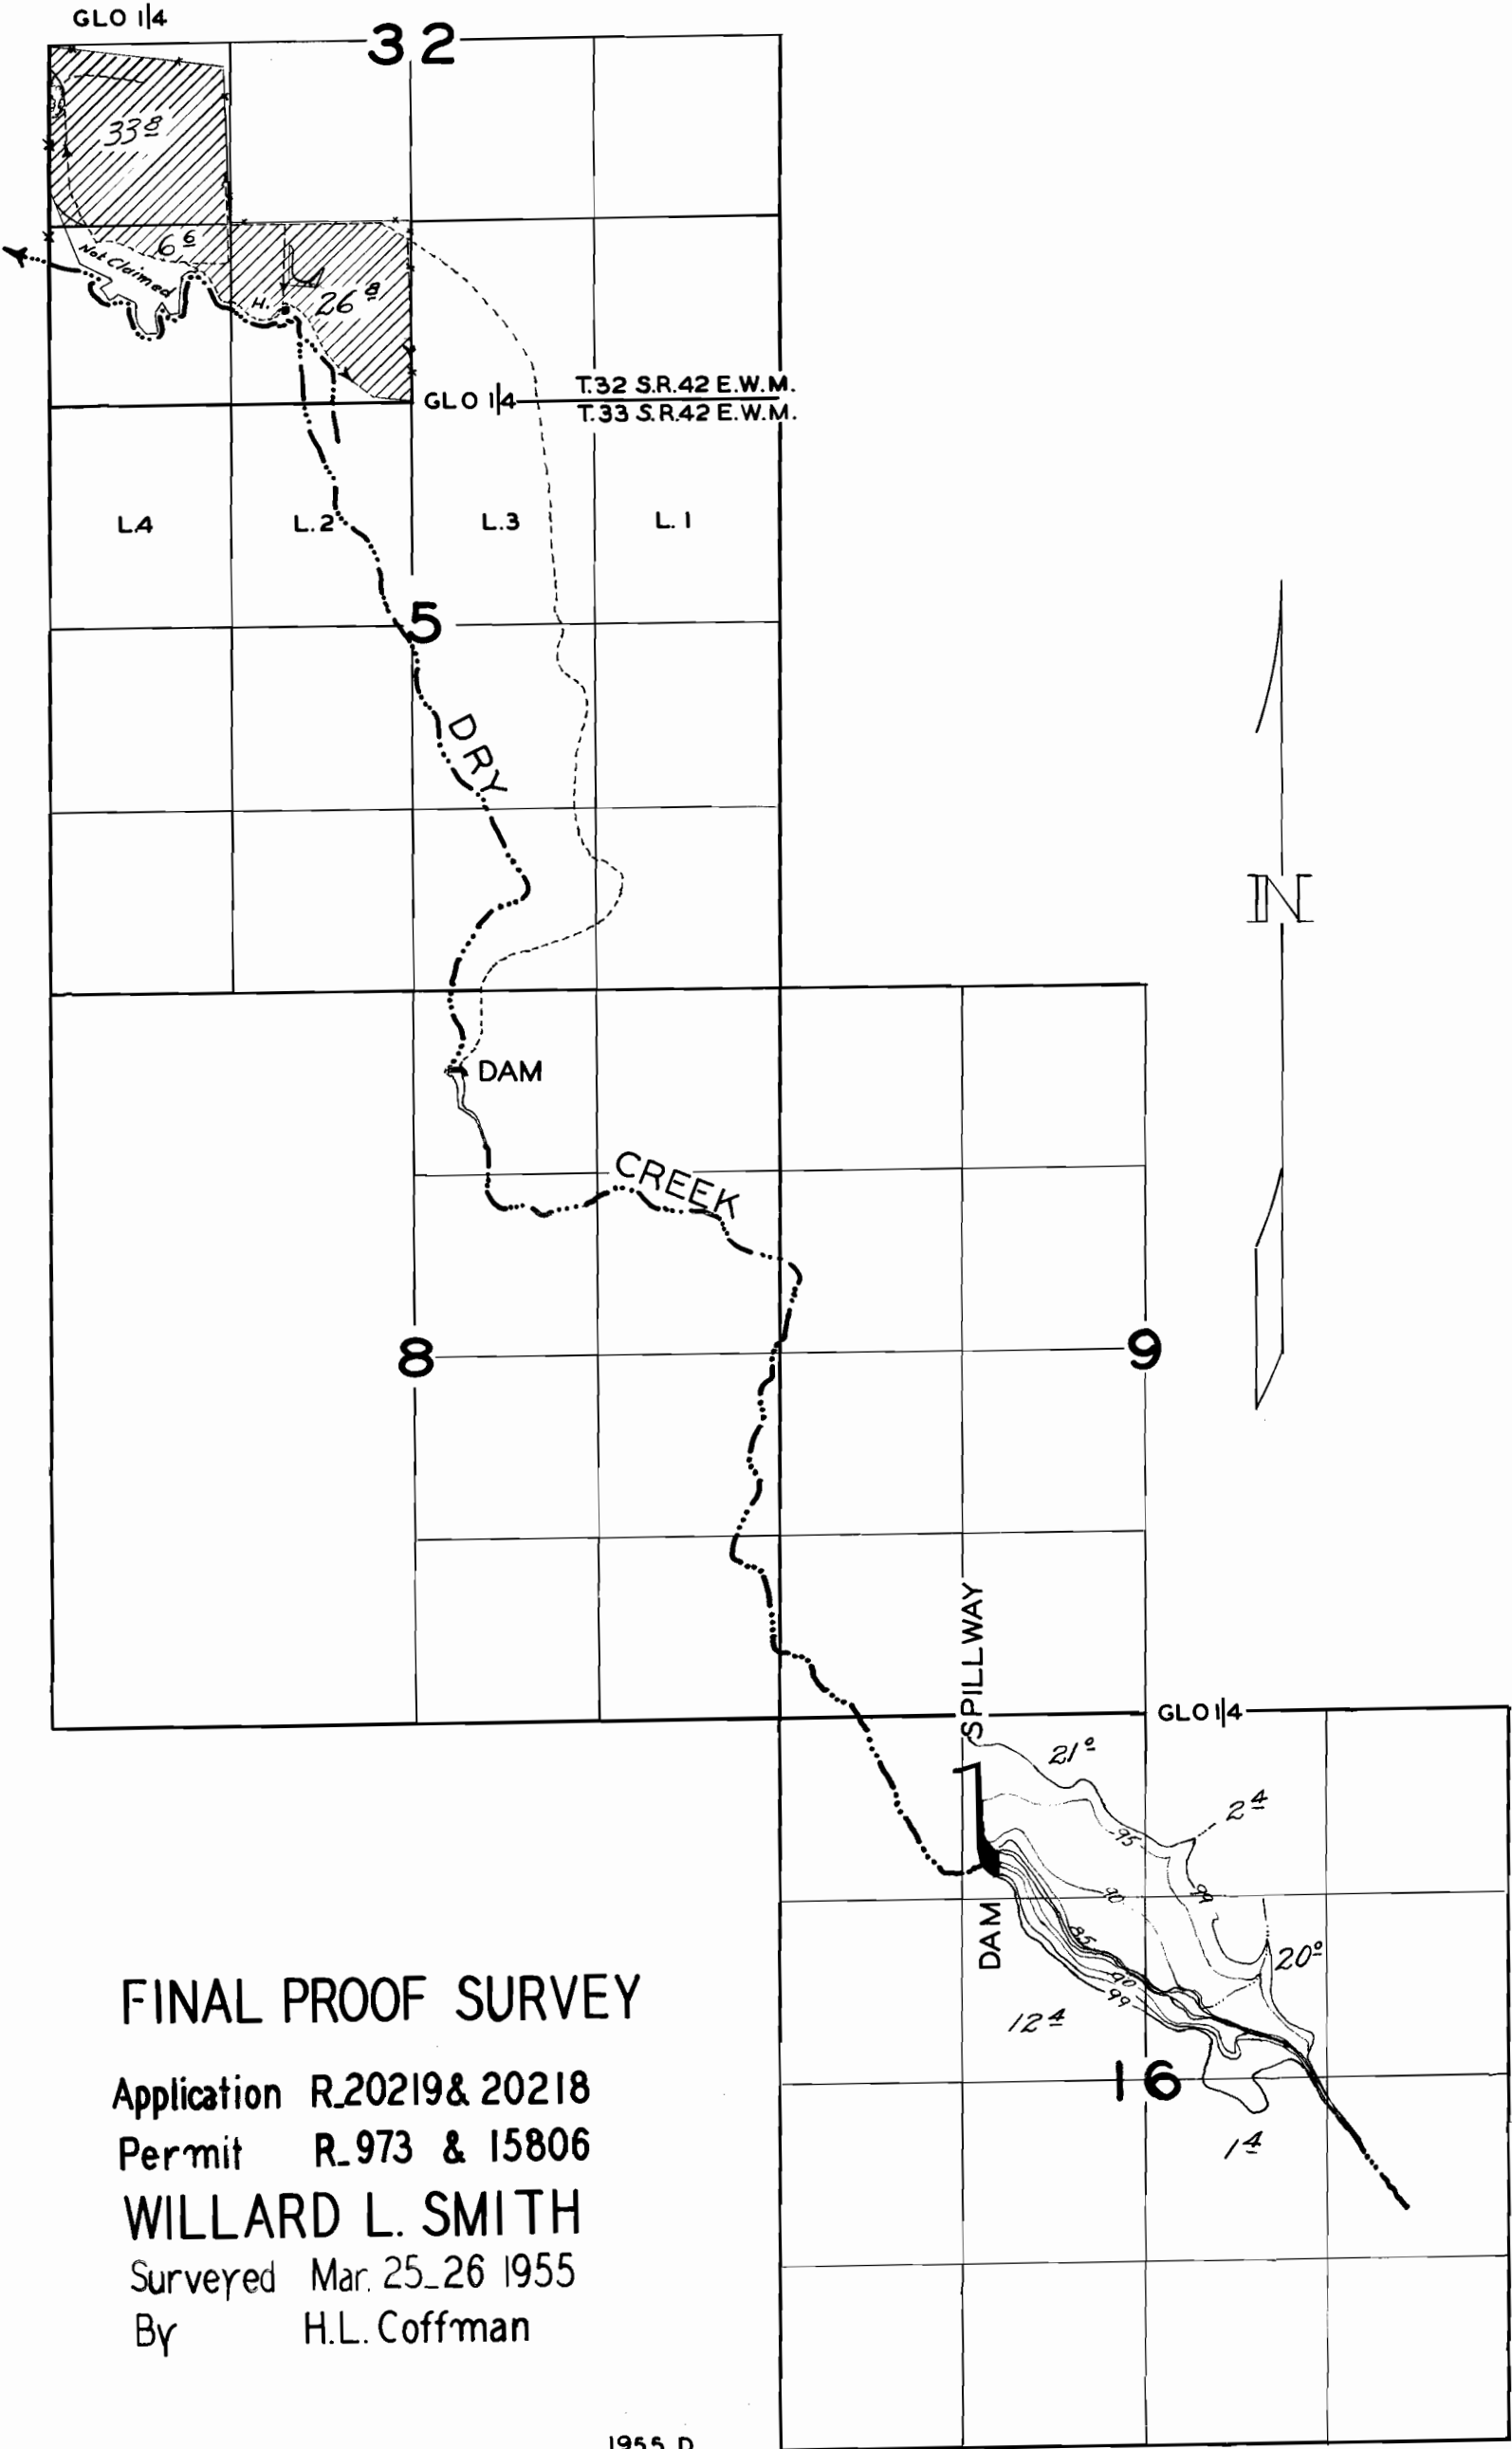

FINAL PROOF SURVEY

Application R.20219 & 20218  
Permit R.973 & 15806  
WILLARD L. SMITH  
Surveyed Mar. 25-26 1955  
By H.L. Coffman