


T. 2 S. R. 5 E. W. M.

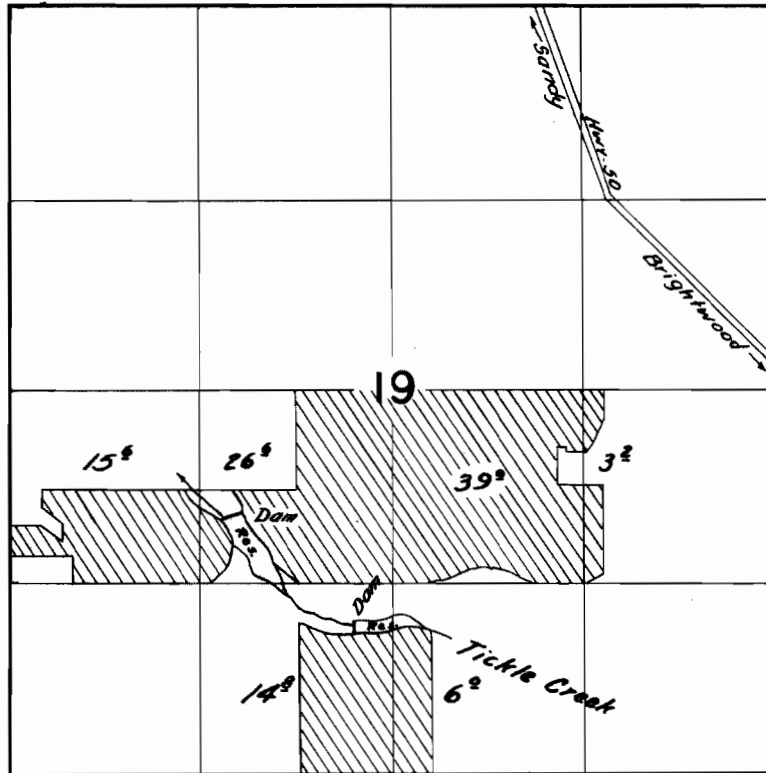

FINAL PROOF SURVEY

UNDER

Application No. ~~24647~~ ^{R-24646} Permit No. ~~19654~~ ^{R-1055}

IN NAME OF

L. W. Fyfe & Son

Surveyed June 15, 1956, by R. H. Whitby

DFK-4D-80

C.B.