


T. 7 S. R. 45 E. W.M.

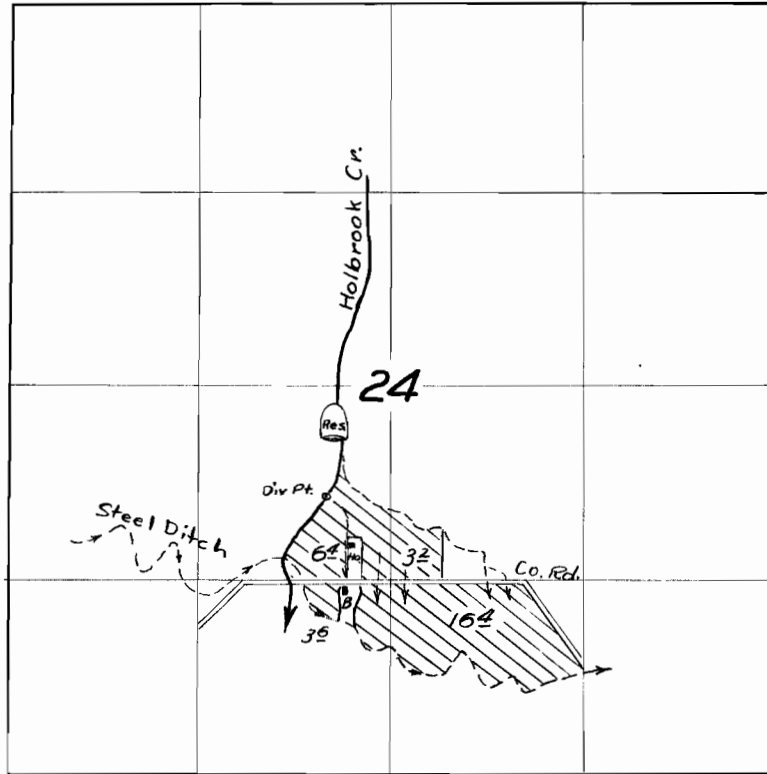

FINAL PROOF SURVEY

UNDER

R-25086

R-1131

Application No. 25087. Permit No. 20204.

IN NAME OF

Francis L. Motley

Surveyed *Oct. 17, 1956*, by *M. Bish*.