


- SPECIFICATIONS FOR ERECTING CONTRACTOR:
- 1) GRUB OUT AREAS "J" & "K" WITHIN PROPERTY, BURN BEANS.
 - 2) DOZE AREA WITHIN DYKE TO ELEVATION 352.
 - 3) BARE TOP SOIL REMOVED FROM BUILDING, DAM, TANK, & RAILWAY BEDS.
 - 4) BUILD DYKE APPROACHES & TANK MOUNDS IN 4 LAYERS, USE MATERIAL MOVED IN SPECIFICATION 2); IF EXTRA MAT'L IS NEEDED PAWD DEPTH WILL BE INCREASED.
 - 5) BUILD UP BUILDING AREA "N" TO ELEVATION 442 WITH GRAVEL & CLAY.
 - 6) IN BUILDING DYKE & FILLER DOZE TOP SOIL WITHIN CONCRETE CONTRACTOR, WITH 10% B.S. FILLING DUMPS, BLOCK CANALS, & BUILDING FOOTINGS.
 - 7) SEE WALL "L" THE ORIGINAL VOLUME OF THE DYKE IS TO BE MAINTAINED WITH BATES, DRAINAGE CONTRACTOR, THIS PROPERTY SECTION IS 8' WIDE.
 - 8) ALL FILLS ARE TO BE BUILT IN LAYERS OF 6" WITH CAREFUL SPREADING & COMPACTED.
 - 9) BUREAU SURVEYORS OF ROADWAY TO LOG DUMP & SUPPLY 4' WIDENED & CORNERED GRAVEL.
 - 10) SIDES OF DYKE ARE SHOWN 1/2% TO 1% SLOPE, WHICH IS ABOUT NATURAL ANGLE OF REPOSE OF MATERIAL. NO GRADIENT OR SURVEY IS REQUIRED.
 - 11) GRADE TOP OF DYKE, RAILWAY BEDS, & BUILDING SURF LEADS TO BUREAU TOP STAGES.

ALTERATION	BY	DATE

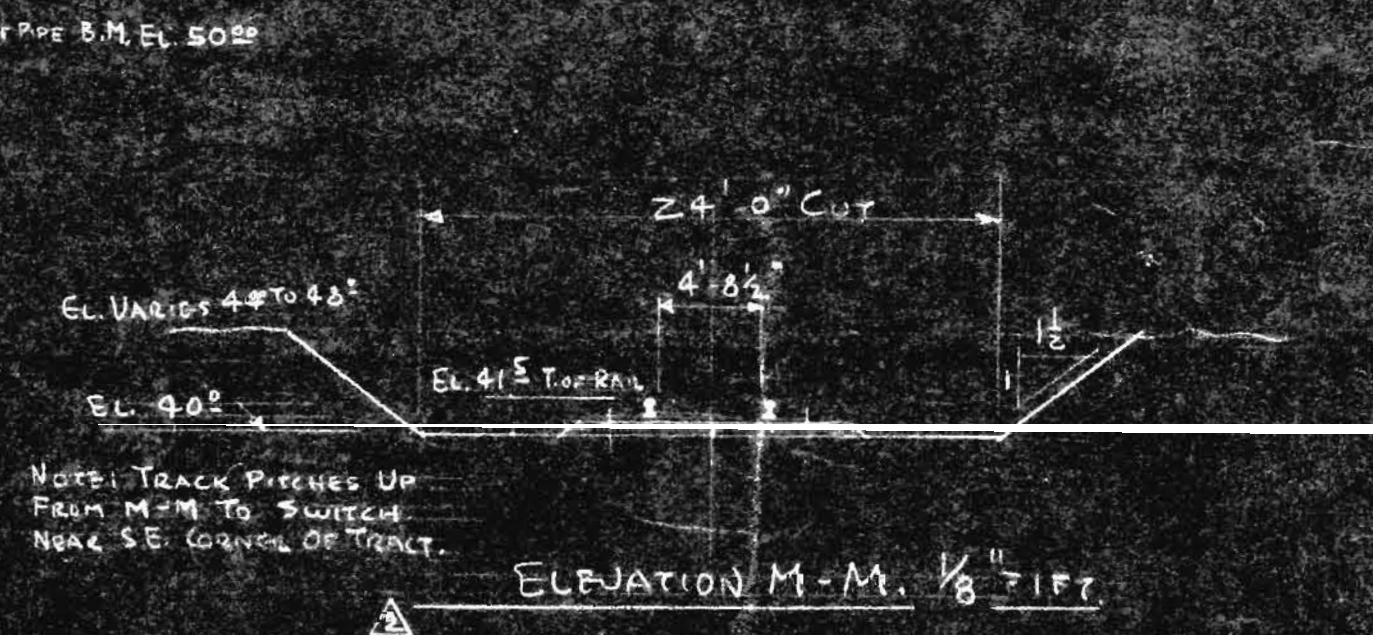

D POND CONSTRUCTION

TRACK DUMP 1/8"=1FT SEE 41999



SCALE	DATE	DRAWN	CHECK	JOB NO.	DATE
1"=100 FT.	24 JUNE 1914	L.S.		222	

61976

MARION CO.

NORTH FORK

LINN CO.

SANTIAM RIVER

ALTERNATE PUMPHOUSE LOCATION

PUMPHOUSE LOCATION

CRACKED FLAT ROCK
IN RIVER BED &
CROOKED TREE ON BANK.

MONUMENT CONSISTING OF
1 1/2" DIA. AXLE, 36" LONG, 30" INTO GROUND

POINT 3864.21 FROM
SOUTH 1/4 SECTION POINT.
B.W. FENCE

N-S. CTR. LINE OF
SEC. 20 TN. 9S. R. 2E. W.M.

WINDOW WEIGHT

30 FT. PRIVATE R. OF
W. FOR PIPE LINE
FROM HWY 222
TO RIVER.

3800 FT. OF 12" WATER PIPE
FROM PUMP AT RIVER
TO LOG POND.

CREEK TO RIVER

QUARTER SECTION
POINT

EAST BDRY. SEC. 20. T9S. R2E. W.M. N. 0°29' E. 1151.8'

INTERSECTION OF SECTION
CENTER LINE & NORTH R. OF W.
LINE OF HIGHWAY.

STATE HIGHWAY 222

PIPE UNDER HWY.
CROSSING "A"

NOTE "C": PIPE UNDER
COUNTY ROAD R. OF W.

COUNTY ROAD

TRENCH (COVERED)
20" R. OF W. FOR
TRENCH.

881.5'

OVERFLOW
FOR DETAIL OF PIPE
ADJUSTMENT SEE 61974

IDANHA VENEER CO.
15 AC. POND.
FOR DETAILS SEE 61976

CROSSING "B"
24" PIPE UNDER
HIGHWAY

PLANT

I, LAWRENCE SUPOVE OF PORTLAND, OREGON DO HEREBY
CERTIFY THAT THIS MAP WAS MADE FROM NOTES TAKEN
DURING AN ACTUAL SURVEY MADE UNDER MY IMMEDIATE SUPERVISION
ON SEPT 11, 1951; THAT THE MONUMENT SHOWN ON THIS MAP CONSISTING
OF A 1 1/2" DIA. AXLE IS N. 0°37' E. 3864.21' AND N. 89°23' W. 391.91' FROM SOUTH
QUARTER SECTION POINT OF SECTION 20, T9S; R2E, WILLAMETTE MERIDIAN.
LAWRENCE SUPOVE



SOUTH BDRY. SEC. 20 T9S R2E W.M.
N. 89°11' W. 2647.3' (1/2)

(IRON BOLT)
S.E. COR. SEC. 20. TN. 9S. R. 2E. W.M.

MR.	ALTERATION	DATE	BY	WATER SUPPLY LINE & DRAIN LINE.
1		12 SEPT 51	LS	
				IDANHA VENEER COMPANY LYONS PLANT LYONS, OREGON
				1" = 300 FT 28 AUG 51 NORM BURKE L.S. 222 41990