


T.1S. R.3W. W.M.

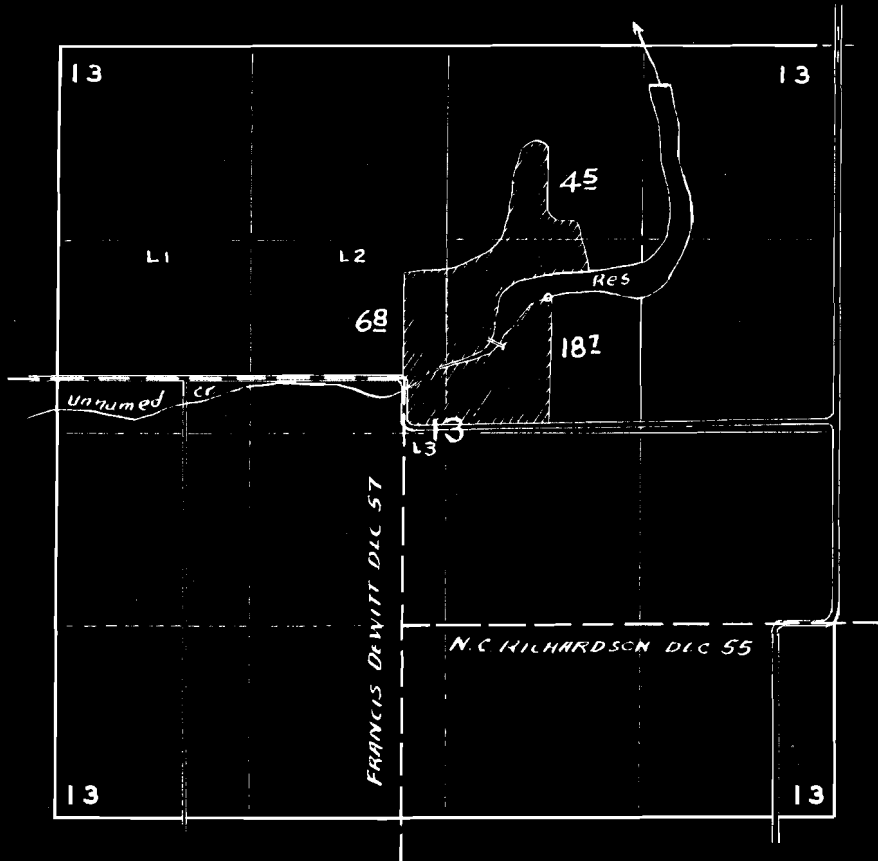

R-26586

R-1273

26587

20827

IN NAME OF

W.J. KALSCH

Surveyed 4-27 1956 by R.H. WHITBY