


T. 7 S. R. 3 W. W. M.

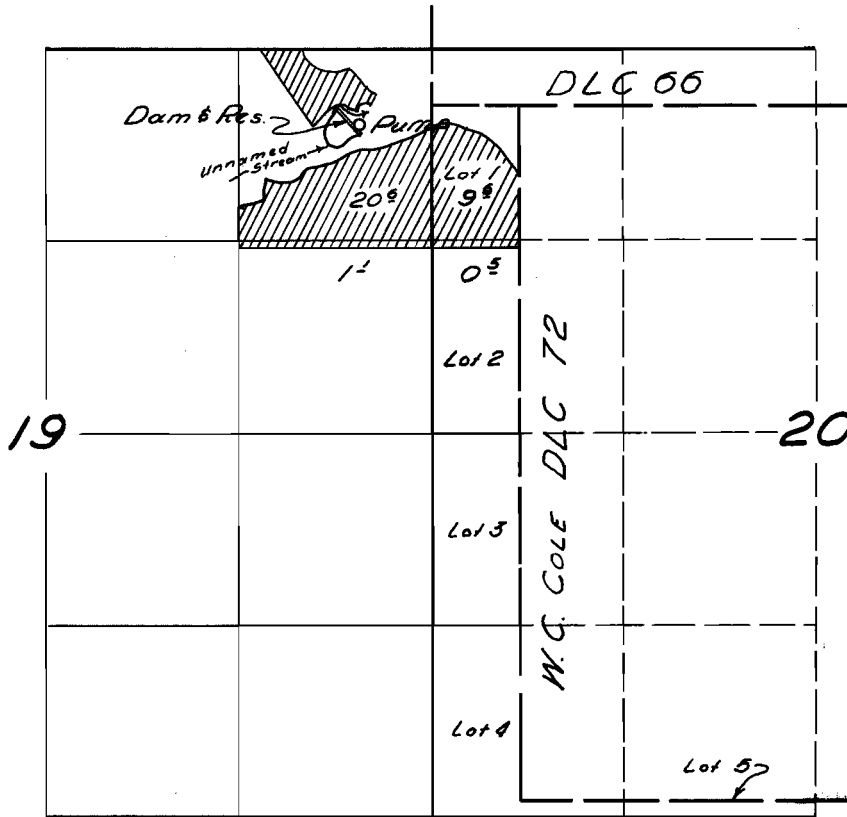

FINAL PROOF SURVEY

UNDER

R-25592

R-1148

Application No. 25593 Permit No. 20227

IN NAME OF

T. J. SHIPLER

Surveyed 4 Sept 1956, by [Signature]