


T.2S., R.2W., W.M.

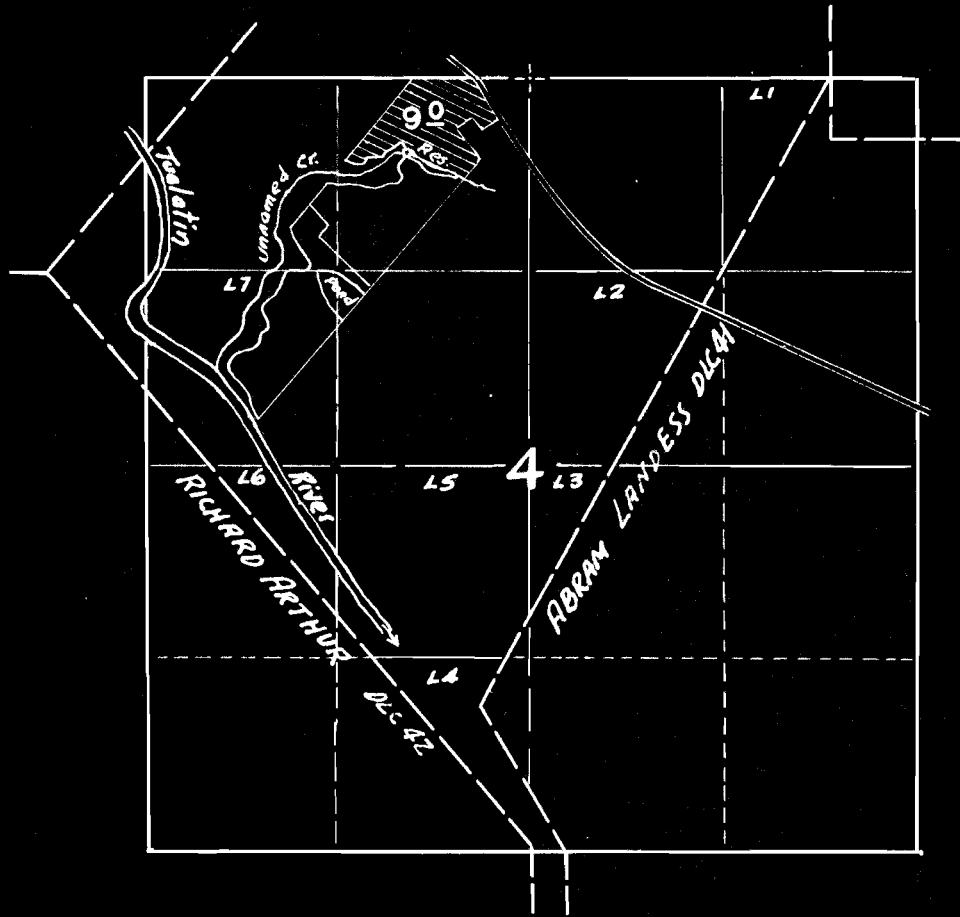

FINAL PROOF SURVEY

UNDER

R-26660

R-1284

Application No. 26661 Permit No. 20879

IN NAME OF

VICTOR D. FOSTER, ESTATE

Surveyed 4 - 27 1956, by M. BISH