T. 2 S., R. 2 W., W.M.

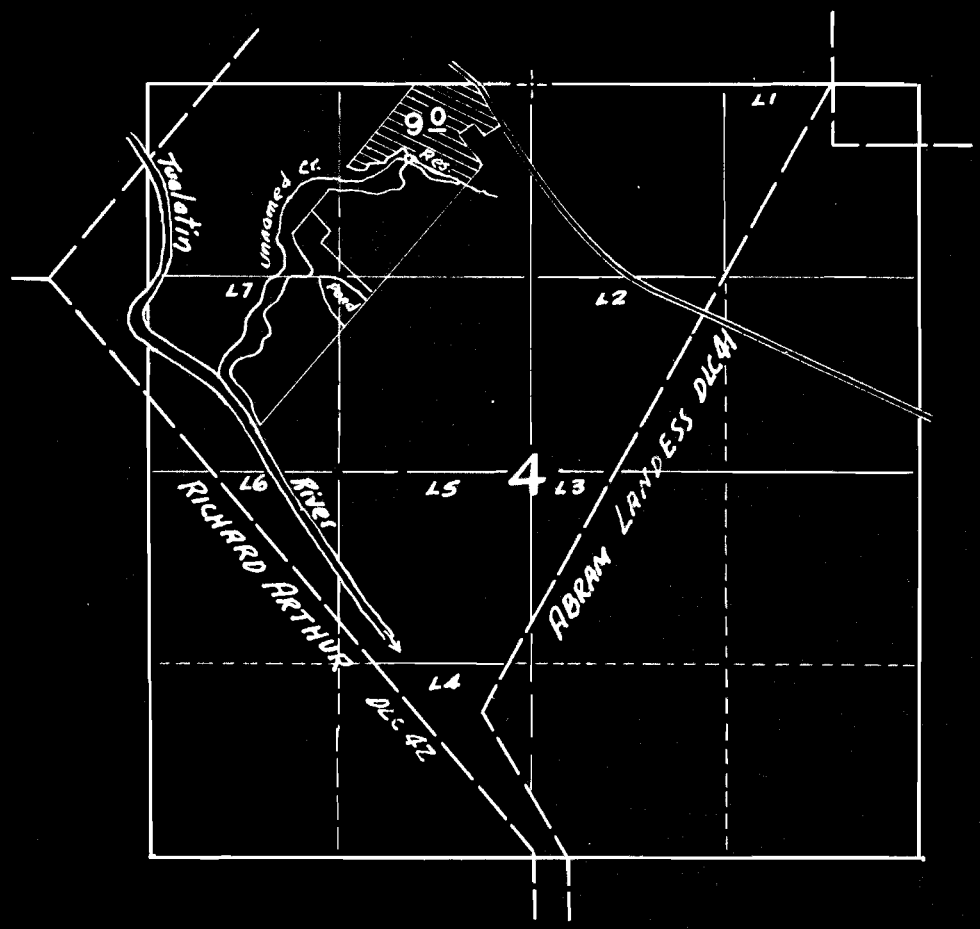

FINAL PROOF SURVEY

UNDER

R-26660 R-1284

Application No. 26661 Permit No. 20879

IN NAME OF

VICTOR D. FOSTER, ESTATE

Surveyed 4-27 1956, by M. BISH

DFR-2D-58 WC