


T. 1 N., R. 4 W., W.M.

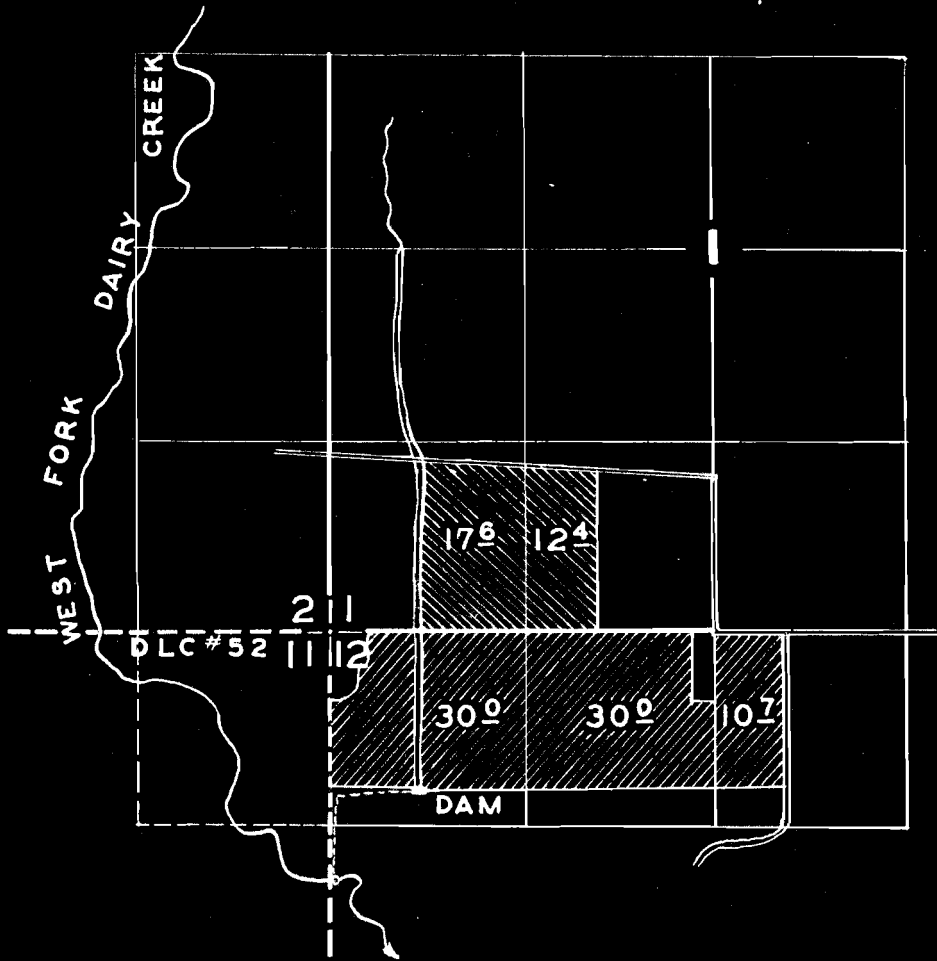

FINAL PROOF SURVEY

R-25488 UNDER

R-1302

25489

20969

Application No. 25490

Permit No. 20970



IN NAME OF

GERALD I. & ANTHONY P. HERB

Surveyed 4 - 13, 1956, by R.H. WHITBY.