


T. 1 N. R. 4 W. W. M.

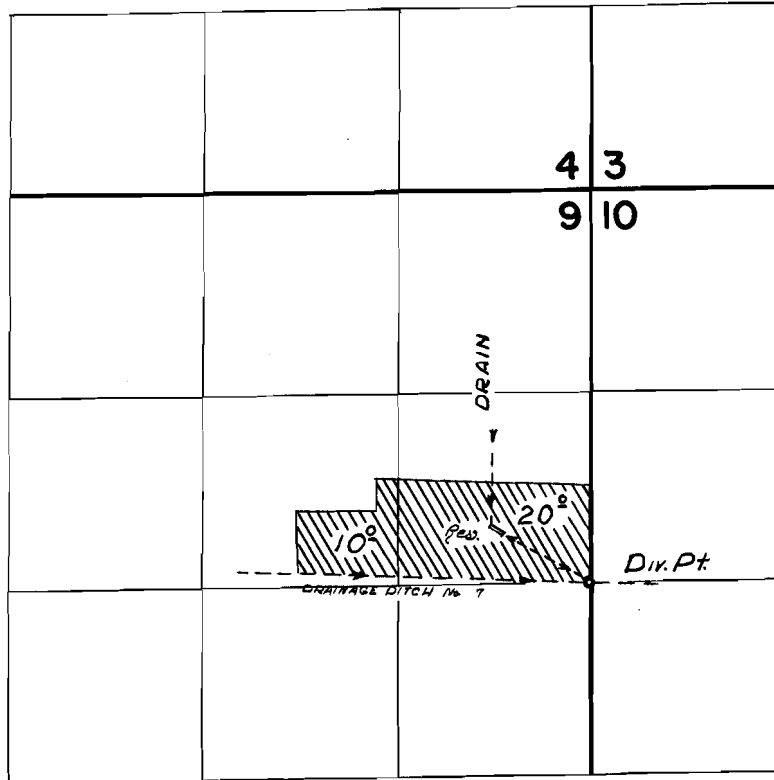

**FINAL PROOF SURVEY**  
UNDER

*R-26862*                      *R-1325*  
Application No. *26863* Permit No. *21094*  
IN NAME OF

ALVIN & THERESA MEURY

Surveyed *April 13* 1956, by *R. D. Best*