


T. 1 N. R. 4 W. W. M.

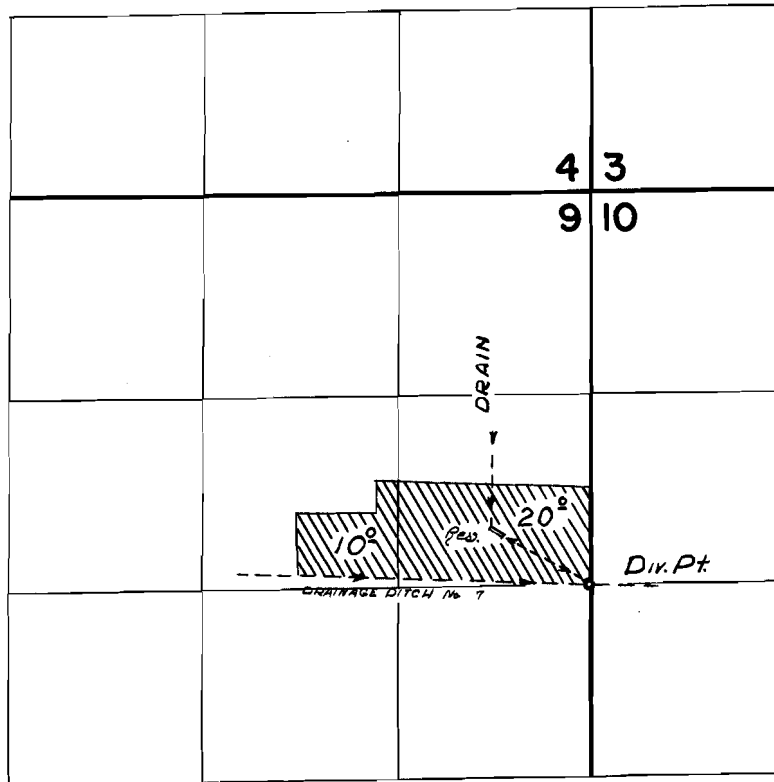

FINAL PROOF SURVEY
UNDER

R-26862 *R-1325*
Application No. *26863* Permit No. *21094*
IN NAME OF

ALVIN & THERESA MEURY

Surveyed *April 13* 1956, by *R. D. Best*