


T. 5S. R. 1E. W.M.

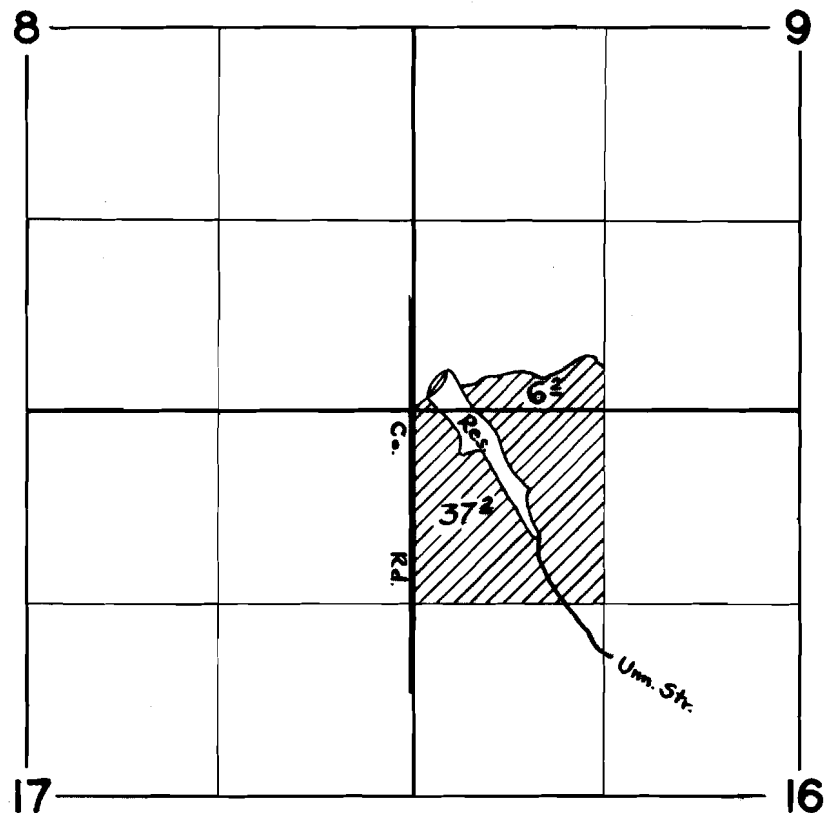

FINAL PROOF SURVEY

UNDER

R-25371

R-1349

Application No. ~~25372~~ Permit No. ~~21234~~

IN NAME OF

RAY J. ZIELINSKI

Surveyed 21 MAR. 1956 by R.D. BEST

DFK-3D-45
1956 B

Art