


T. 2 S., R. 3 W., W. M.

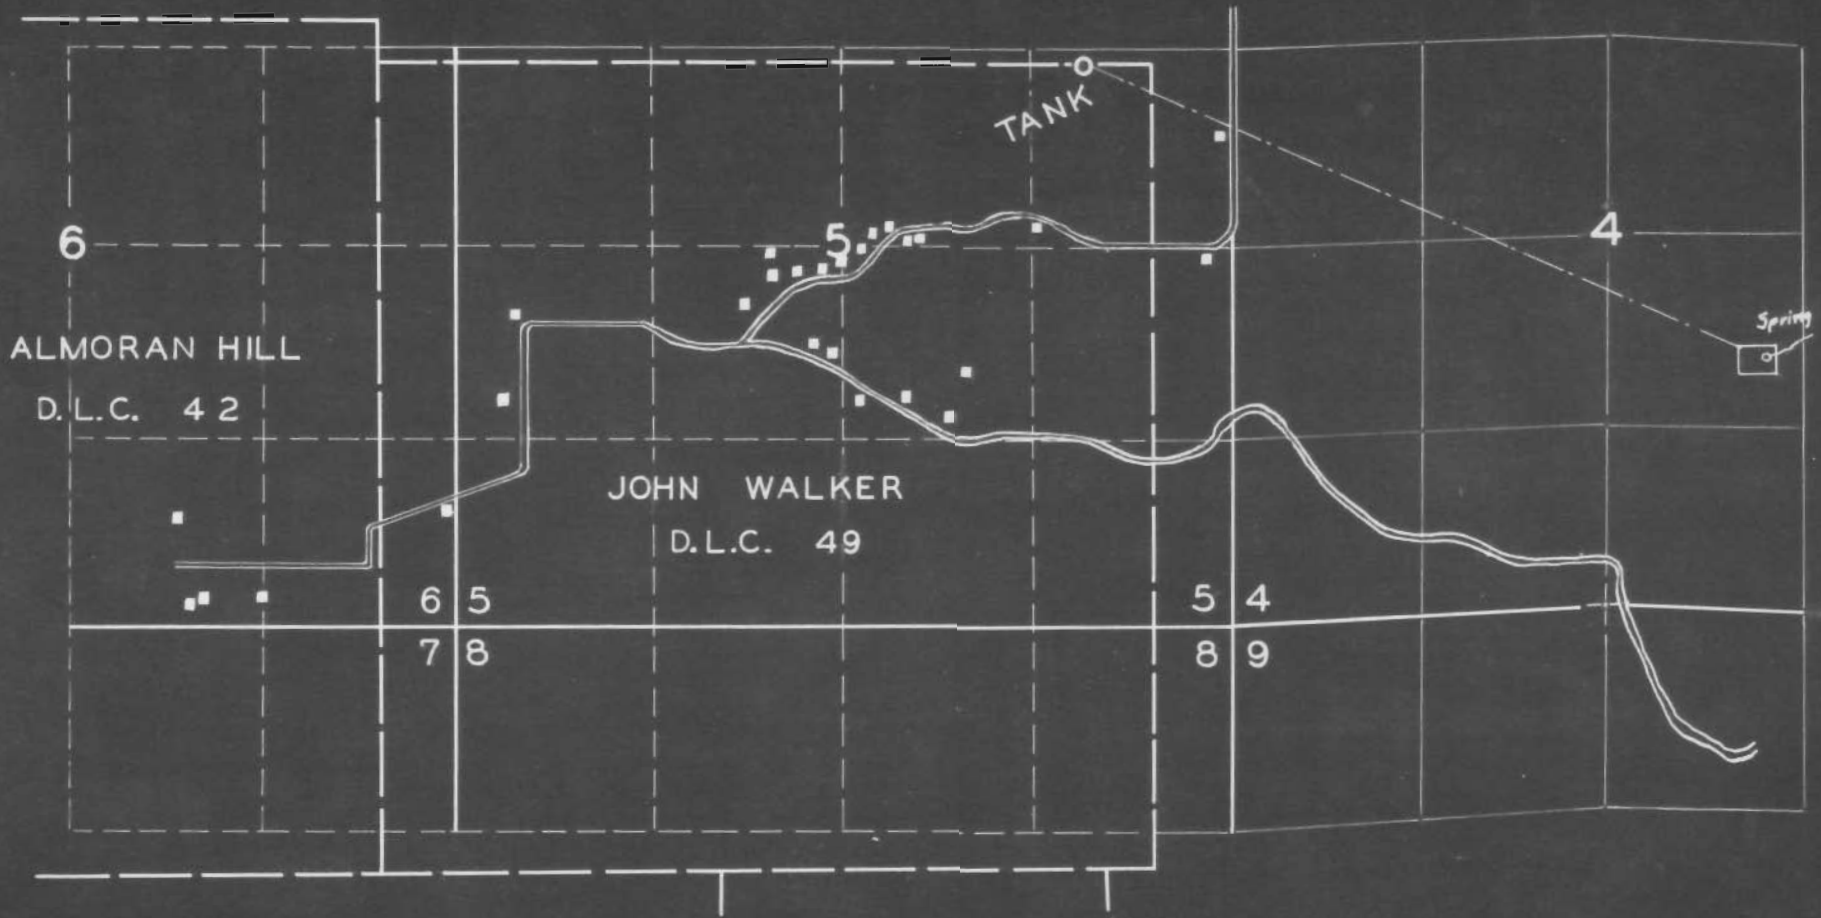

FINAL PROOF SURVEY

UNDER

R-28745

R-1508

APP. NO. 28746

PERMIT NO. 22408

IN NAME OF

LAURELWOOD WATER USERS CO-OPERATIVE

SURVEYED 4-26-1956 BY R.D. BEST