


T.7S.R.1E.W.W.

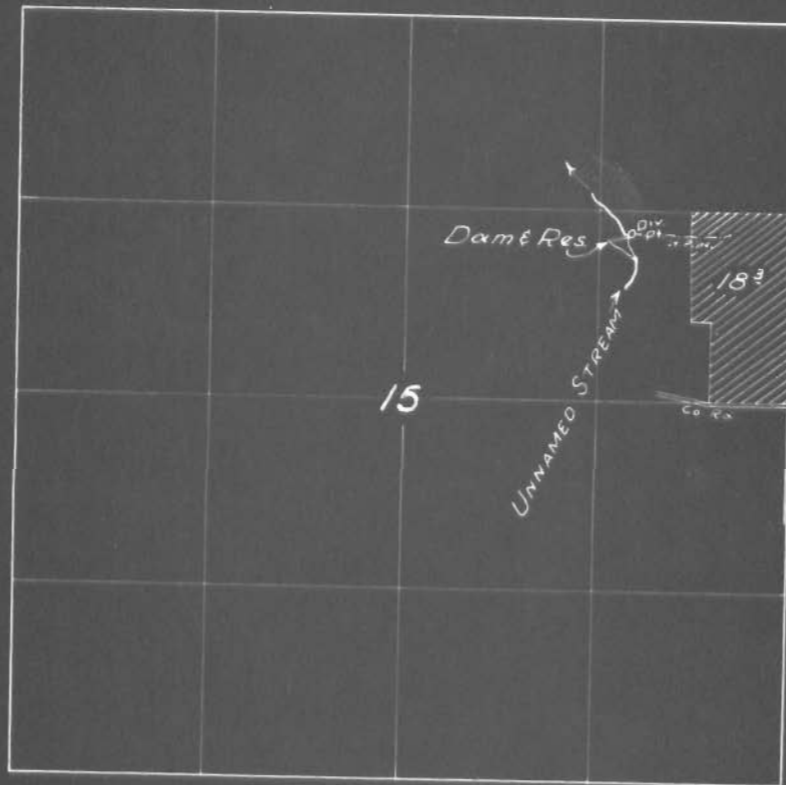

FINAL PROOF SURVEY

UNDER

24829

19672

28818

22679

Application No. R-28817 Permit No. R-1577

IN NAME OF

LOUIS PFLAUM

Surveyed 24 May 1956, by *R. H. Hickey*