


T. 1 S. R. 3 W. W. M.

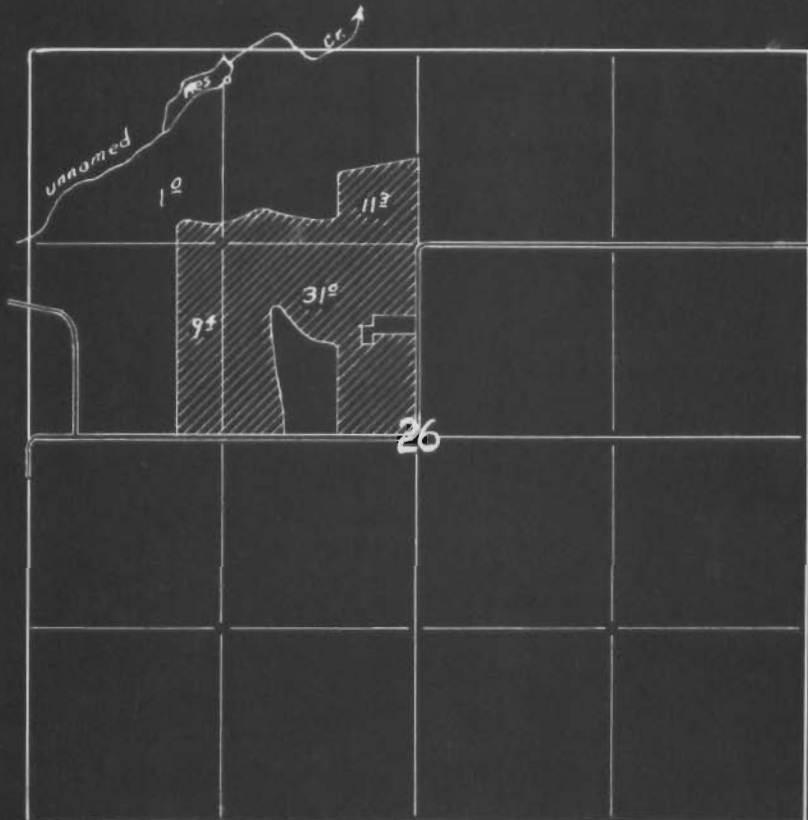

FINAL PROOF SURVEY

UNDER

R - 29248

R - 1650

Application No. 29249

Permit No. 23076

IN NAME OF

WILHELM GUTKNECHT

Surveyed 5 - 1 1956, by R.H. WHITBY.